


Section 25 Township 34 Range 1E

Well No. 1 Clifton

Company Aladdin Pet.

Wildcat
NORTH

//

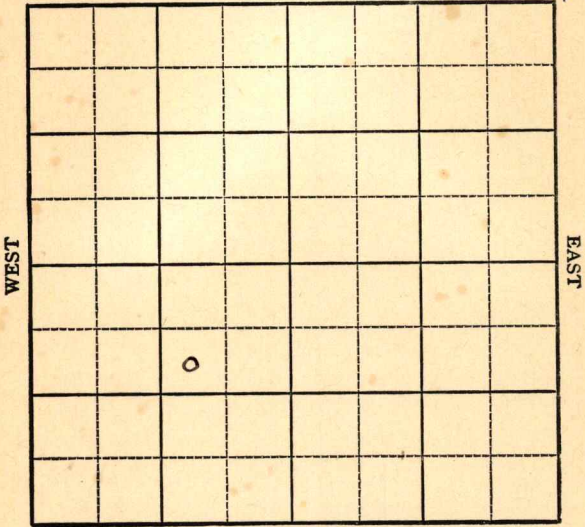

SOUTH

KANSAS

Summer



Sec. 25 Twp. 34 R. 1E

Well No. #1 Clifton Farm _____

Aladdin Pet. Company _____

Wildcat


990' Ft. from N. Line

_____ Ft. from S. Line

990' Ft. from E. Line

_____ Ft. from W. Line

SW NE SW

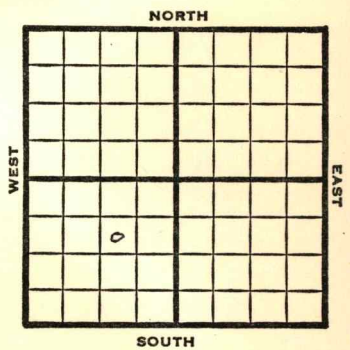

1949	Level 1159' REPORT
1/12	Location
1/19	"
1/26	"
2/2	"
2/9	10" @ 103' Drlg 400'
2/16	Drlg. 1270'
2/23	Topeka 1782' Lansing 2400' Stalnaker 2408' Drlg. 2765'
3/2	Lans. 2857' corrected Miss 3547' Drlg. 3734'
3/9	TD 3865' Simp 3827' Aband.
ABANDONED	

Map No. _____ Sec. 25 Twp. 34 R. 1E

Well No. 1 Clifton

Aladdin Pet.

Company _____

FIRST REPORT

Contractor _____

SW NE SW

SECTION PLAT

990 Ft. from N. Line

_____ Ft. from S. Line

990 Ft. from E. Line

_____ Ft. from W. Line

Summer County

RECORD

Location X

Cased _____ in., _____ ft.

Rig up _____

Sand _____

Drilling and Remarks:

Gas _____

Oil _____

Total Depth _____

PRODUCTION

1st 24 hrs. Nat. _____

1st 24 hrs. after shot _____

Gas _____ Cu. Ft.

Dry Hole _____

Abandoned _____

Date

JAN 12 1949 19

S. J. LEWIS Scout

Map No. K1 Sec. 25 Twp. 34 R. 1E

Well No. 1 Clifton

Aladdin Pet. Company

ABANDONED

Contractor

SW NE SW

E 1159
SECTION PLAT

990 Ft. from N. Line

_____ Ft. from S. Line

990 Ft. from E. Line

_____ Ft. from W. Line

Sumner County

Location _____

Rig up _____

Drilling and Remarks:

Surf 3827

RECORD

Cased _____ in., _____ ft.

Sand _____

Gas _____

Oil _____

Total Depth 3865

PRODUCTION

1st 24 hrs. Nat. _____

1st 24 hrs. after shot _____

Gas _____ Cu. Ft.

Dry Hole _____

Abandoned _____

Date

MAR 9 1949 19

S. J. LEWIS

Scout