


Section 25 Township 34 Range 2 E

Well No. # 1 Baird

Company Orville Parker

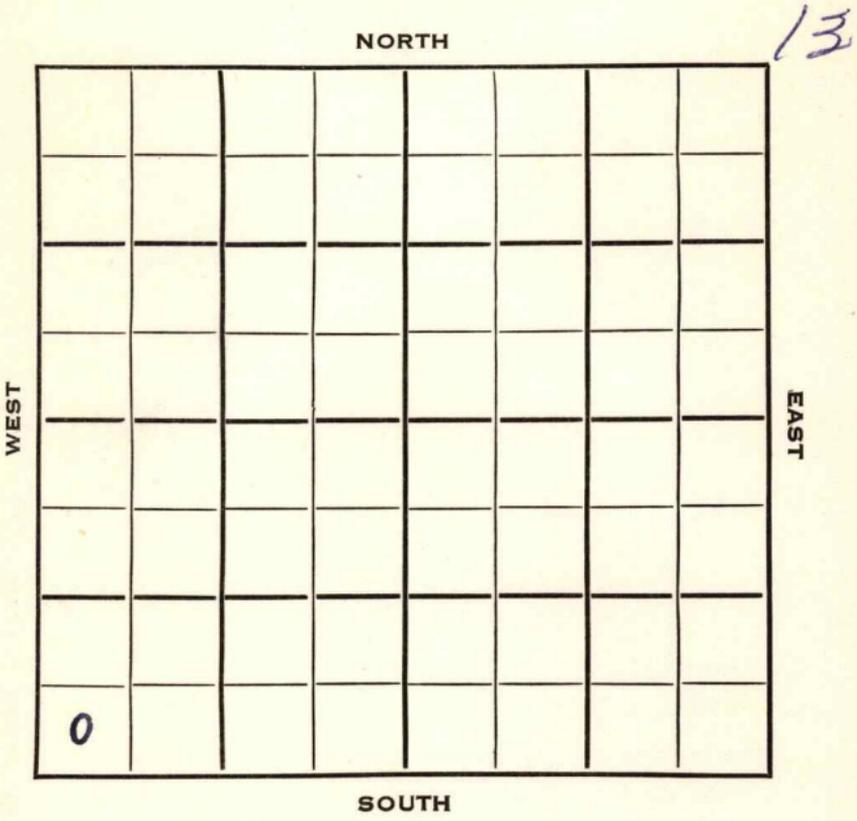

Summer

KANSAS

SEC. 25	TWP. 34	R. 2 E
------------	------------	-----------

WELL NO. # 1 Baird FARM

COMPANY Orville Parker

CONTRACTOR Drisswell


_____ Ft. from N. Line

330 _____ Ft. from S. Line

_____ Ft. from E. Line

330 _____ Ft. from W. Line

SW SW SW

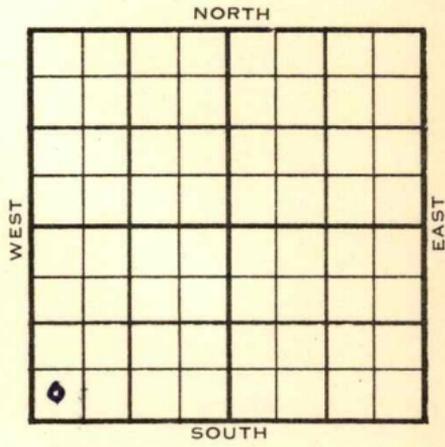

1953	ELEVATION 1224'	REPORT
------	--------------------	--------

9/16 Spud 9-11-53
8" @ 85
Drlg. 1380'

11/11 Spud 9-11-53
Oil Well
TD 3525'
8" @ 85'
Bart 3515'
DST 3515-25, opn 45 mins., gas in 40 mins., rec. 65' oil, 30' socm, 1140#
TD 3525'
5" @ 3515,
CO to 3525, FU 200' oil 1 hr.,
S/3½ boph 48 hrs.
Comp. 26 bopd

COMPLETED

County Sumner State Kansas

Sec. 25 (Blk. 34) (Sur. 2E) (Twp.) (Rge.) Map No.

Operator Orville Parker

Well No. 1 Farm Baird

Elev. _____ Location SW SW SW

330 Ft. From S Line SW

330 Ft. From W Line Quarter

1st. Report SEP 16 1953

Completion _____

Remarks _____

Drisswell - Contr.

Spudding Date 9-11-53

Drlg. Data _____

8" @ 85 drlg. 1380

J. G. MCGEHEE

County Sumner State Kansas

Sec. 25 (Blk. 34 (Sur. 2E (Twp. 34 (Rge. 2E Map No.

Operator Orville Parker

Well No. 1 Farm Baird

Elev. 1224 Location SW SWSW

330 Ft. From S Line SW

330 Ft. From W Line Quarter

1st. Report

Completion NOV 11 1953

Remarks

Drisswell - Contr.

Spudding Date 9-11-53

Drlg. Data Oil well TD 3525

8" @ 85 Bart. 3515 DST 3515-25

open 45 min. gas in 40 min. Rec. 65'

oil 30' socm 1140# TD 3525

5" @ 3515 CO to 3525 FU 200' oil 1 hr.

S/ 3½ boph 48 hr. Comp. 26 bopd