


Section 25 Township 34 Range 2E

Well No. 3 Baird

Company O. H. Parker

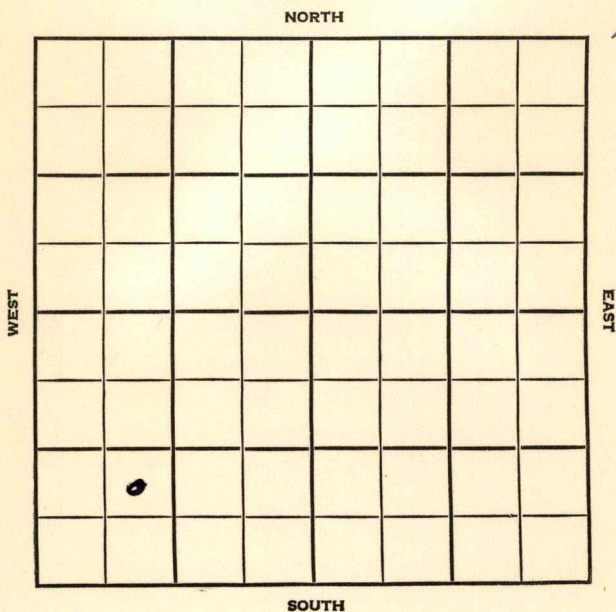

SEC. 25	TWP. 34	R. 2E
------------	------------	----------

WELL NO.

3 Baird

FARM

COMPANY

O. H. Parker

CONTRACTOR

Smitherman Contr.


Hilltop Pool

_____ Ft. from N. Line

990 _____ Ft. from S. Line

_____ Ft. from E. Line

990 _____ Ft. from W. Line

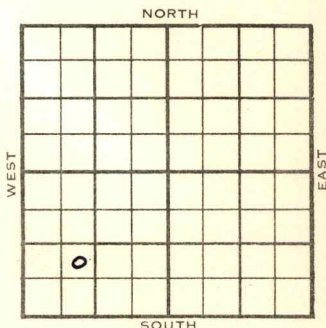

NE SW S"

	ELEVATION	REPORT
1954	1232	
6/9	Spudding 6-5-54 8" @ 86 Drlg. 1550	
12/7	Spudded 6-5-54 Oil well TD 3526 8" @ 86	
	Stal 2096 Layton 2812 KC 2990 Cleveland land 3132 Big. lime 3206 Bary. 3498 Bart. sd. 3511 Miss. 3526 TD 3526 5" @ 3526 52/ 3510-23 oil in 2 min. F/ 200 bo 4 hr. F/ 82 bo 1 hr. F. 50- boph Comp. 25 bopd	

COMPLETED

County **Sumner** State **Kansas**

Sec. **25** (Blk. **34** (Sur. **2E** Map No. **177**)
(Twp.) (Rge.)

Operator **O. H. Parker**

Well No. **3** Farm **Baird**

Elev.	Location	NE	SW	SW

990 Ft. From S Line SW

990 Ft. From **W** Line Quarter

1st. Report **JUN 9 1954**

Completion

Remarks

Smitherman - Contr.

Spudding Date 6-5-54

Drig. Data Hilltop Pool

8" @ 86 drlg. 1550

J. G. McGEHEE

County Sumner State KansasSec. 25 (Blk.) 34 (Sur.) 2E Map No.Operator O. H. ParkerWell No. 3 Farm BairdElev. 1232 Location NE SW SW990 Ft. From S Line SW990 Ft. From W Line Quarter

1st. Report

Completion JUL 7 1954Remarks Hilltop PoolSmitherman - Contr.Spudding Date 6-5-54Drlg. Data Oil well TD 35268" @ 86 Stal. 2096 Layton 2812KC 2990 Cleveland 3132 Big. lime 3206Bart. 3498 Bart. sd. 3511 Miss. 3526TD 3526 5" @ 3526 52/ 3510-23oil in 2 min. F/ 200 bo 4 hr.F/ 82 bo 1 hr. F. 50 bophComp. 25 bopd