

Section 25 Township 34 Range 2EWell No. #7
#6 BairdCompany Orville Parker

NORTH

14

WEST

EAST

0

SOUTH

SEC.	25	TWP.	34	R.	2E
------	----	------	----	----	----

WELL NO. ~~#7~~
#6 Baird

COMPANY FARM

Orville Parker

CONTRACTOR

Smitherman

Ft. from N. Line


330

Ft. from S. Line

330

Ft. from E. Line

Ft. from W. Line

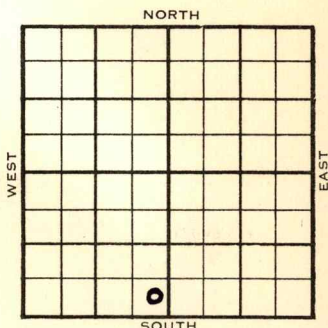

SE SE SW (Twin well)

	ELEVATION	REPORT
1954	1236'	

8/11 Location

9/29 Spud 9-10-54
Oil well TD 3571 8-5/8" @ 114
Bart 3504 B. Bart 3535'
TD 3571 5" @ 3571 23/3517-24
3/3526-27 15/3531-36 sd-frac.
F/25 BOPH Comp. 25 BOPD

COMPLETED

County Sumner State KansasSec. 25 (Blk.
Twp.) 34 (Sur.
Rge.) 2E Map No.Operator Orville ParkerWell No. 7 Farm Baird (Twin)Elev. 1236 Location SE SE SW330 Ft. From S Line SW330 Ft. From E Line Quarter1st. Report Aug 11 1954Completion SEP 29 1954

Remarks

SmithermanSpudding Date 9-10-54Drlg. Data Oil well TD 35718 5/8" @ 114 Bart. 3504 B. Bart. 3535TD 3571 5" @ 3571 23/ 3517-243/ 3526-27 15/ 3531-36 sd-fracF/ 25 boph Comp. 25 bopd

FABEN GILSTRAP

Kansas

Map No. _____ Sec. 25 Twp. 34 R. 2EWell No. 7 Baird


Orville Parker _____ Company

CORRECTION

Contractor

SE SE SW (twin well)

SECTION PLAT

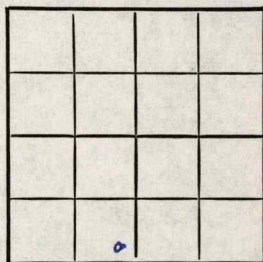

_____ Ft. from N. Line

330 Ft. from S. Line330 Ft. from E. Line

_____ Ft. from W. Line

Sumner County

Location _____

Rig up _____

Drilling and Remarks:

Reported

#6 Baird

RECORD

Cased _____ in., _____ ft.

Sand _____

Gas _____

Oil _____

Total Depth _____

PRODUCTION

1st 24 hrs. Nat. _____

1st 24 hrs. after shot _____

Gas _____ Cu. Ft.

Dry Hole _____

Abandoned _____

Date

AUG 18 1954 19

FABEN GILSTRAP

Scout

County Sumner State Kansas

Sec. **25** (Blk. **34** (Sur. **2E** Map No.

Operator **Orville Parker**

Well No. **6** Farm **Baird**

Elev.	Location	SE SE SW
FIRST REPORT

330 Ft. From S Line SW

330 Ft. From E Line Quarter

1st. Report AUG 11 1954

Completion

Remarks *for review*

Spudding Date _____

Drlg. Data

Location

72