


Section 25 Township 34 Range 2 E

Well No. # 8 Baird

Company O. Parker

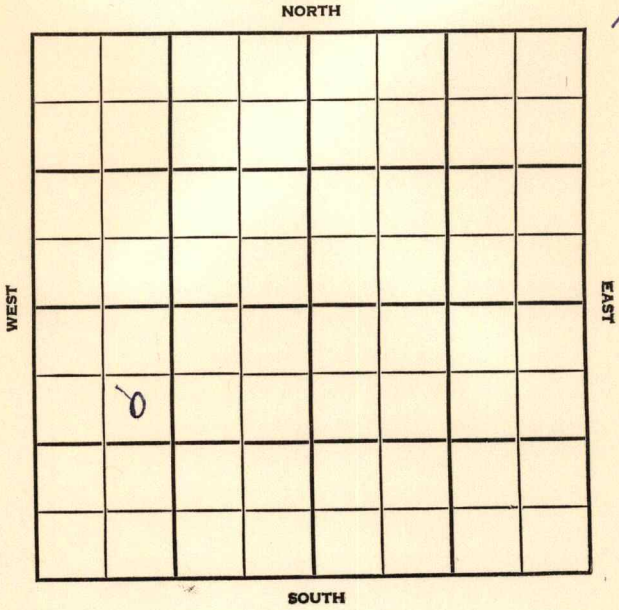

KANSAS

County Summer State KansasSec. 25 (Blk.) 34 (Sur.) 2E Map No.Operator O. ParkerWell No. 8 Farm BairdElev. Location SE NW SW

990 Ft. From N Line SW990 Ft. From W Line Quarter1st. Report NOV 23 1954

Completion

Remarks

Smitherman - Contr.Spudding Date 11-22-54Drlg. Data Hilltop Pool8" @ 115 WOC

FABEN GILSTRAP

County Sumner State Kansas
 Sec. 25 (Blk. Twp.) 34 (Sur. Rge.) 2E Map No. _____
 Operator O. Parker
 Well No. 8 Farm Baird
 Elev. 1235 Location SE NW SW

990 Ft. From N Line SW
 990 Ft. From W Line Quarter

1st. Report _____

Completion DEC 22 1954

Remarks Hilltop Pool
Smitherman - Contr.

Spudding Date 11-22-54

Drlg. Data Oil well TD 3544

8" @ 115 Layton 2822 KC 3000

Big lime 3210 Bart. 3501 Miss. 3524

TD 3544 5" @ 3544 CO to 3537

72/ 3508-24 S/ 1 boph 8 hr. F/ 25 boph

Comp. 25 bopd

FABEN GILSTRAP