

Map No. *Sumner* **KANSAS** Sec. *26* Twp. *34* R. *2^E*

Well No. *1-Sumner* Farm

Marland Oil Company

NORTH

WEST

EAST

| | | | | | | | |
|---|--|--|--|--|--|--|--|
| | | | | | | | |
| | | | | | | | |
| | | | | | | | |
| | | | | | | | |
| 0 | | | | | | | |
| | | | | | | | |
| | | | | | | | |
| | | | | | | | |

12

SOUTH

Location.....

Rig Up.....

Drilling Remarks

Drilling Remarks

.....

.....

RECORD

PRODUCTION

Cased..... in..... ft.

1st 24 hrs. Nat.....

Sand.....

1st 24 hrs. after shot.....

Gas.....

Gas..... cu. ft.....

Oil.....

Dry Hole.....

Total Depth.....

Abandoned.....

Map No. **KANSAS** Sec. 26 Twp. 34 R. 2^E


Well No. 1- Purry Farm
Marland Oil Company

330 Ft. from N. Line

_____ Ft. from S. Line

_____ Ft. from E. Line

330 Ft. from W. Line

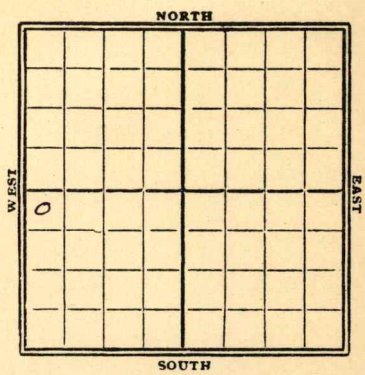

1929

| Date | REPORT |
|------|--|
| 2/20 | Location |
| 2/27 | Pick up. |
| 3/6 | |
| 3/13 | Spdy 210' |
| 3/20 | Dry 1170' |
| 3/27 | 6 M gas 1544-55 2 M gas 1575-HFW run 12" - 1575' |
| 4/3 | dry 1922' |
| 4/10 | " 2110' |
| 4/17 | " 2175' |
| 4/24 | " 2425' |
| 5/1 | " 2535' |
| 5/8 | 15 M gas at 2425 T.D. 2770' mud off gas |
| 5/15 | |
| 5/22 | dry 3215' |
| 5/29 | " 3435' |
| 6/5 | " 3438' |
| 6/12 | set 5" - 3450' (over) |

6/19- Chat 3444-85'

T.D. 3485'

2 M gas

495 bbls oil

Pump.

Sumner

MAP No. **KANSAS** SEC. 26 TWP. 34 R. 25

WELL No. 41 1 Curry

Standard Oil COMPANY

CONTRACTOR

SECTION PLAT

| | | | |
|---|--|--|--|
| | | | |
| | | | |
| 0 | | | |
| | | | |

330 FT. FROM N. LINE

FT. FROM S. LINE

FT. FROM E. LINE

330 FT. FROM W. LINE

FIRST REPORTS

LOCATION ✓

RIG UP

DRILLING AND REMARKS:

RECORD

CASED _____ IN. _____ FT.

SAND _____

GAS _____

OIL _____

TOTAL DEPTH _____

PRODUCTION

1ST 24 HRS. NAT. _____

1ST 24 HRS. AFTER SHOT _____

GAS _____ CU. FT.

DRY HOLE _____

ABANDONED _____

DATE

FEB 20 1929 192

S. J. LEWIS SCOUT

Map No. **KANSAS** Sec. 26 Twp. 34 R. 2E

Well No. 1 Curry

Marland Oil Company

Contractor

SECTION PLAT

330 Ft. from N. Line

..... Ft. from S. Line

..... Ft. from E. Line

330 Ft. from W. Line

| | | | |
|---|--|--|--|
| | | | |
| | | | |
| 0 | | | |
| | | | |

COMPLETED

Location.....

Rig up.....

Drilling and Remarks:

Chas 3444-80

2 M Gas

495 ft oil

RECORD

Cased..... in., ft.

Sand.....

Gas.....

Oil.....

Total Depth 3485

PRODUCTION

1st 24 hrs. Nat.....

1st 24 hrs. after shot.....

Gas..... Cu. Ft.

Dry Hole.....

Abandoned.....

Date

JUN 19 1929

192

CHAS. L. SHERWOOD

Scout