


Map No. **KANSAS** Sec. 26 Twp. 34 R. 2E

Well No. 2 - Curry Farm

B. D. Hawker Company

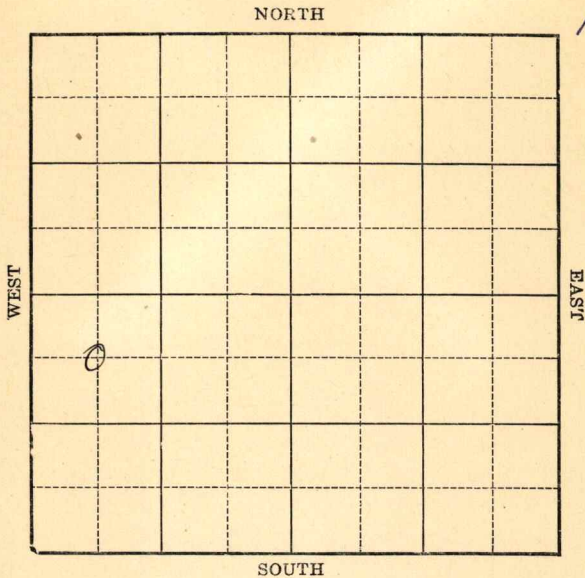

Location \_\_\_\_\_  
Drilling Remarks \_\_\_\_\_

Rig Up \_\_\_\_\_  
Drilling Remarks \_\_\_\_\_

\_\_\_\_\_

\_\_\_\_\_

**RECORD**

Cased \_\_\_\_\_ in. \_\_\_\_\_ ft.

Sand \_\_\_\_\_

Gas \_\_\_\_\_

Oil \_\_\_\_\_

Total Depth \_\_\_\_\_

**PRODUCTION**

1st 24 hrs. Nat. \_\_\_\_\_

1st 24 hrs. after shot \_\_\_\_\_

Gas \_\_\_\_\_ cu. ft.

Dry Hole \_\_\_\_\_

Abandoned \_\_\_\_\_



*Summer*

Map No. **KANSAS** Sec. *26* Twp. *34* R. *2* <sup>E</sup>

Well No. *2*

*E. B. Shawver* Company

Contractor

**FIRST REPORTS**

**SECTION PLAT**

*660* Ft. from N. Line

..... Ft. from S. Line

..... Ft. from E. Line

*660* Ft. from W. Line

<i>0</i>			

Location.....

Rig up.....

Drilling and Remarks:

*Spdy*

**RECORD**

Cased.....in., .....ft.

Sand.....

Gas.....

Oil.....

Total Depth.....

**PRODUCTION**

1st 24 hrs. Nat.....

1st 24 hrs. after shot.....

Gas.....Cu. Ft.

Dry Hole.....

Abandoned.....

Date

**APR 16 1930**

**CHAS. L. SHERWOOD**

192.....

Scout

*Summer*

**KANSAS**

Map No. \_\_\_\_\_ Sec. 26 Twp. 34 R. 2<sup>E</sup>

Well No. 2 *Curry*  
E. B. Shawver Company

Contractor

**COMPLETE**

**SECTION PLAT**

660 Ft. from N. Line

\_\_\_\_\_ Ft. from S. Line

\_\_\_\_\_ Ft. from E. Line

660 Ft. from W. Line

0			

Location \_\_\_\_\_

Rig up \_\_\_\_\_

Drilling and Remarks:

*Shot 10 gts*

*500# RP*

**RECORD**

Cased \_\_\_\_\_ in., \_\_\_\_\_ ft.

Sand 1557-660

Gas \_\_\_\_\_

Oil \_\_\_\_\_

Total Depth 1566

**PRODUCTION**

1st 24 hrs. Nat. \_\_\_\_\_

1st 24 hrs. after shot \_\_\_\_\_

Gas 24 1/4 Cu. Ft.

Dry Hole \_\_\_\_\_

Abandoned \_\_\_\_\_

Date

**MAY 7 1930**

**CHAS. L. SHERWOOD**