


Section 26 Township 34 Range 2-E

Well No. #1 Fee

Company E B Shawoes

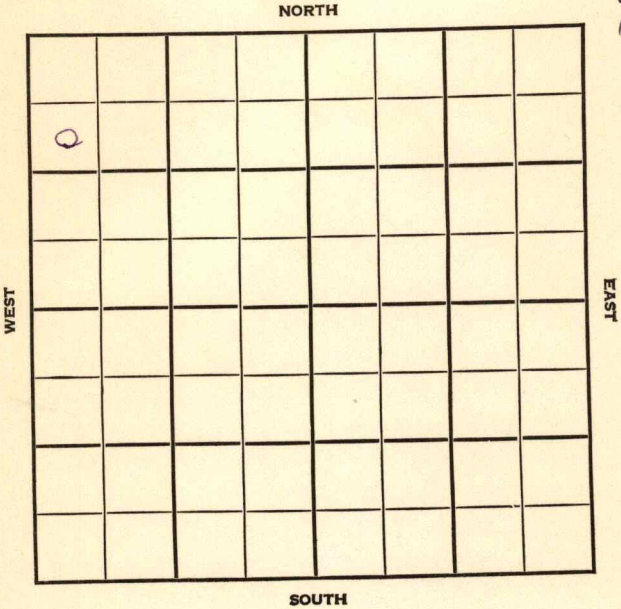

KANSAS

Sumner

Sec. 26 Twp. 34 R. 2E

Well No. #1 Fee Farm

E. B. Shawoes Company


Miscellaneous

990' Ft. from N. Line

 Ft. from S. Line

 Ft. from E. Line

330' Ft. from W. Line

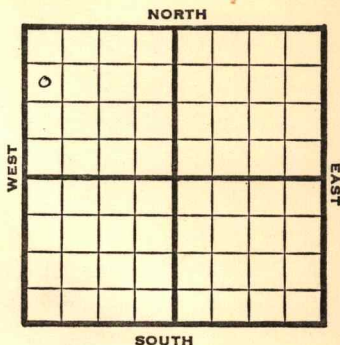

SW NW NW

1948

Eli 1222' REPORT

7/21 RUR

7/28 8"@ 127'
Drlg 1315

8/4 Drlg. 3167'

8/11 **Mississippi 3467'-72'**
TD 3472'
5"@ 3472'

8/18 Drlg 3507' SQ

8/25 **Miss 3467'**
5"@ 3472'
TD 3522'
Pump 35 oil / 8 W Pot
39° Gr.

Comp

COMPLETED

Miscellaneous

Map No. _____ Sec. 26 Twp. 34 R. 2E

Well No. 1 Fee

E. B. Shawoos Company

FIRST REPORT Contractor

SW NW NW

SECTION PLAT

6			

990 Ft. from N. Line

_____ Ft. from S. Line

_____ Ft. from E. Line

330 Ft. from W. Line

Summer County

Location _____

Rig up _____

Drilling and Remarks:

RUR

RECORD

Cased _____ in., _____ ft.

Sand _____

Gas _____

Oil _____

Total Depth _____

PRODUCTION

1st 24 hrs. Nat. _____

1st 24 hrs. after shot _____

Gas _____ Cu. Ft.

Dry Hole _____

Abandoned _____

Date

JUL 21 1948 19____

S. J. LEWIS Scout

Sumner County Kansas State

Map No. 1 Sec. 26 Twp. 34 R. 2E

Well No. 1 Fee.

E. B. Shawver Company

COMPLETE

Contractor

SW NW NW

E 1.1222
SECTION PLAT

990 Ft. from N. Line

 Ft. from S. Line

 Ft. from E. Line

330 Ft. from W. Line

6							

Miscellaneous

Remarks:

Mis 3467

5' 3472

7173522

Pung 3500 + 5W 204

37 2/3

Date
AUG 25 1948

Scout **S. J. LEWIS**