


KANSAS

Sumner

Section 26 Township 34 Range 2E

Well No. #1 Hansen

Company Orville Parker

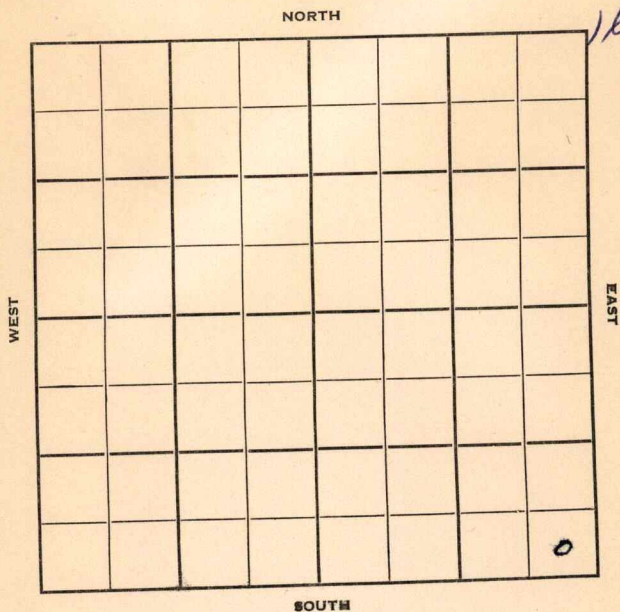

Sumner

KANSAS ✓

Sec. 26 Twp. 34 R. 2EWell No. #1 Hansen FarmOrville Parker

Company


Contractor

Ft. from N. Line

330 Ft. from S. Line330 Ft. from E. Line

Ft. from W. Line

SE SE SE

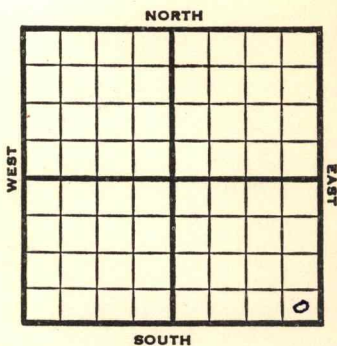

1953

Elev. 1223' REPORT

3/18

8" @ ?

6/10

Abandoned Location

ABANDONED

J. G. McGEHEE

J. G. McGEHEE