


Sumner

KANSAS

Section 27 Township 34 Range 2E

Well No. #5 Norrish

Company Continental Oil Company

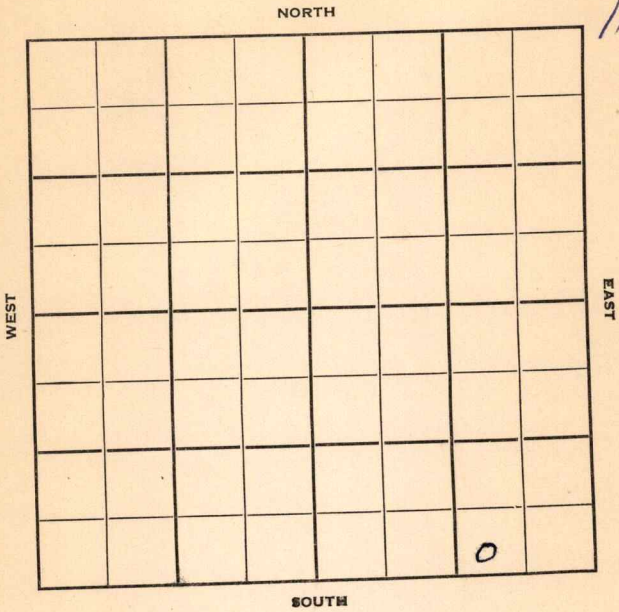

Sumner

FORM 252-B

KANSAS

Sec. 27 Twp. 34 R. 2E

Well No. #5 Norrish Farm

Continental Oil Company Company

Dave Morgan - Contr. Contractor

Padgett Pool


Ft. from N. Line

330 Ft. from S. Line

990 Ft. from E. Line

Ft. from W. Line

SW SE SE

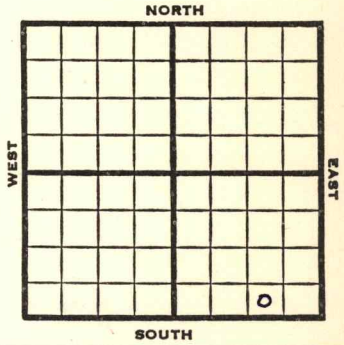

1953

Elev. 1188' REPORT

3/18

Spudded 3/17/53

4/29

Spud 3-17-53 Oil well TD 3516
 8" @ 132 Heeb 2005 Doug. 2108
 Lans 2290 Stal. 2392 Layton 2755
 DST 2756-63 open 1/2 hr ~~KEE~~
 476,000 gas, 20' mud 1080#
 DST 2764-77 open 1 hr rec 60' GCM
 70' SW 1060# Miss 3426
 TD 3516 5" @ 3515 36/3470-76
 S/6 BO 8 BW 12 hr. S/7 BO 9 BW 12 hrs.
 S/42 BO 98 BW 9 1/2 hr.
 Comp. 28 BOPD 113 BW

COMPLETED

