

Sumner
 Map No. **KANSAS** Sec. *27* Twp. *34* R. *2E*
 Well No. *1-Schwartz* Farm
Davis & Harold Company

NORTH

WEST

EAST

							0

SOUTH

Location.....

Drilling Remarks

.....

.....

RECORD

Cased.....in.....ft.

Sand.....

Gas.....

Oil.....

Total Depth.....

Rig Up.....

Drilling Remarks

.....

.....

PRODUCTION

1st 24 hrs. Nat.....

1st 24 hrs. after shot.....

Gas.....cu. ft.....

Dry Hole.....

Abandoned.....


Map No. **KANSAS** Sec. 27 Twp. 34 R. 2 E
Well No. 1-Schwartz Farm
Davis & Harold Pitt Company

990 Ft. from N. Line

..... Ft. from S. Line

330 Ft. from E. Line

..... Ft. from W. Line

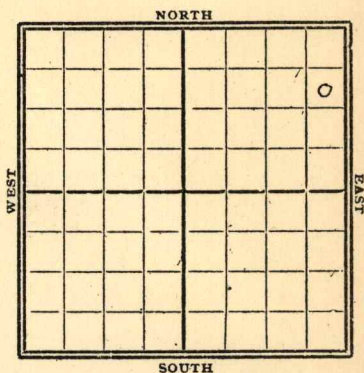

1928

Date	REPORT
12/26	Location
1929	
1/2	Rig
1/9	Rign up
1/16	Spud
1/23	
1/30	drlg 1055'
2/6	8"-1570'
2/13	drlg 1715'
2/20	" 2190'
2/27	" 2385'
3/6	U/R 6"-2660' T.D.
3/13	show oil & 2 1/2 M/gas from 2860-95'
3/20	Drlg 3190'
3/27	Top Chat 3455' T.D. 3505' chat Est 2 M/gas and 200 bbl oil
4/3	Top Chat 3455' T.D. 3497' 1 1/2 M/gas - 184 bbl oil 10 bbl water - Comp.

Map No. KANSAS Sec. 27 Twp. 24 R. 2E

Well No. T. Schwartz

Davis & Harold P. S. Company

Contractor

SECTION PLAT

			0

990 Ft. from N. Line

..... Ft. from S. Line

330 Ft. from E. Line

..... Ft. from W. Line

FIRST REPORTS

Location ✓

Rig up

Drilling and Remarks:

RECORD

Cased.....in.,ft.

Sand.....

Gas.....

Oil.....

Total Depth.....

PRODUCTION

1st 24 hrs. Nat.....

1st 24 hrs. after shot.....

Gas.....Cu. Ft.

Dry Hole.....

Abandoned.....

Date

DEC 26 1928

S. J. LEWIS Scout

Map No. **KANSAS** Sec. *27* Twp. *34* R. *2E*

Well No. *1 Schwartz*

Davis & Harold P. J. Company

Contractor

SECTION PLAT

990 Ft. from N. Line

..... Ft. from S. Line

330 Ft. from E. Line

..... Ft. from W. Line

COMPLETED

			0

Location.....

Rig up.....

Drilling and Remarks:

Top Chas 83455

Total Depth 8497

1 1/2 M Gas

184 yds oil

10 yds water

RECORD

Cased..... in., ft.

Sand.....

Gas.....

Oil.....

Total Depth *8497*

PRODUCTION

1st 24 hrs. Nat.

1st 24 hrs. after shot.....

Gas..... Cu. Ft.

Dry Hole.....

Abandoned.....

Date

APR 3 1929

192.....

S. J. LEWIS

Scout