

Map No. **KANSAS** Sec. 27 Twp. 34 R. 2^E


Well No. 2-Swartz Farm
Davis & Harold Pet Company

330 Ft. from N. Line

_____ Ft. from S. Line

330 Ft. from E. Line

_____ Ft. from W. Line

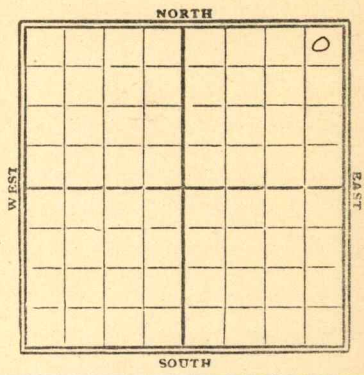

1929

Date	REPORT
9/11	ROD
9/18	
9/25	Run up
10/2	Spud 750
10/19	—
10/16	—
10/23	—
10/30	Spdy
11/6	Wrlg 810'
11/13	" 1160'
11/20	" 1700'
11/27	set 10"- 2000'
12/4	Wrlg 2025' 8"- 2020'
12/11	Wrlg 2420'
12/23	" 2900'
12/30	" 3000'
1930	
1/8	Top chat 3510 Way 3540-48' 1000' oil in hole (over)

1/14- Top Chat 3510'
Oil 3540-48'
T.D. 3548'
15 bbl oil
Pump.

Summer

KANSAS

Map No. _____ Sec. 27 Twp. 34 R. 2^E

Well No. 2 *Swartz*

Davis & Harold Pat Company

Contractor

FIRST REPORTS

SECTION PLAT

330 Ft. from N. Line

_____ Ft. from S. Line

330 Ft. from E. Line

_____ Ft. from W. Line

			0
/			

Location _____

Rig up *Bo 4*

Drilling and Remarks:

RECORD

Cased _____ in., _____ ft.

Sand _____

Gas _____

Oil _____

Total Depth _____

PRODUCTION

1st 24 hrs. Nat. _____

1st 24 hrs. after shot _____

Gas _____ Cu. Ft.

Dry Hole _____

Abandoned _____

Date

SEP 1 1 1929

CHAS. L. SHERWOOD

Summer

Map No. **KANSAS** Sec. *27* Twp. *34* R. *2*^E

Well No. *2 Swartz*

Davis & Harold Company

Contractor

COMPLETE

SECTION PLAT

330 Ft. from N. Line

Ft. from S. Line

330 Ft. from E. Line

Ft. from W. Line

			0

Location

Rig up

Drilling and Remarks:

Top chat 3510

15 Bls.

RECORD

Cased in., ft.

Sand

Gas

Oil *3540-48*

Total Depth *3548*

PRODUCTION

1st 24 hrs. Nat.

1st 24 hrs. after shot

Gas Cu. Ft.

Dry Hole

Abandoned

Date

JAN 15 1930 CHAS. L. SHERWOOD

192 Scout