


Map No. **KANSAS** Sec. 27 Twp. 34 R. 2E

Well No. 1 - Spence Farm
Shawver et al Company

_____ Ft. from N. Line
330 Ft. from S. Line
330 Ft. from E. Line
 _____ Ft. from W. Line

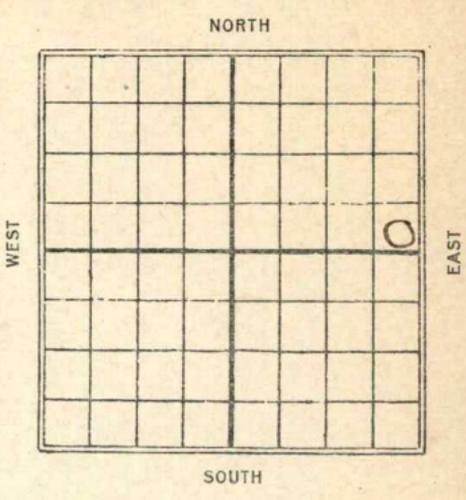

1928

Date	REPORT
6/20	Loc.
6/27	—
7/3	—
7/11	—
7/18	—
7/25	Apud
8/1	Drlg 1215
8/7	1555-75-2 1/2 M gas-drlg 1735 mudded off
8/15	Sp. Ream. 10" - 2040'
8/22	Drlg 2175'
9/5	" 2802'
9/12	T.D. - 2918 V/R 8"
9/19	Top chat 3446'
	6" c 3450 show oil 3475'
	Drlg.
9/26	Top chat 3446'
	T.D. 3520'
	swab 100 bbls.
	Comp

Map No. **KANSAS** Sec. 27 Twp. 34 R. 2E

Well No. 1 Spence

Shawver et al Company

Contractor

SECTION PLAT

----- Ft. from N. Line

330 Ft. from S. Line

330 Ft. from E. Line

----- Ft. from W. Line

			0

FIRST REPORTS

Location ✓

Rig up -----

Drilling and Remarks:

RECORD

Cased ----- in., ----- ft.

Sand -----

Gas -----

Oil -----

Total Depth -----

PRODUCTION

1st 24 hrs. Nat. -----

1st 24 hrs. after shot -----

Gas ----- Cu. Ft.

Dry Hole -----

Abandoned -----

Date

JUN 20 1928

192

S. J. LEWIS

Scout

MAP NO. KANSAS SEC. 27 TWP. 34 R. 2E

WELL NO. 1 Spencer

Shawver & Co COMPANY

CONTRACTOR

SECTION PLAT

			0

_____ FT. FROM N. LINE

330 FT. FROM S. LINE

330 FT. FROM E. LINE

_____ FT. FROM W. LINE

COMPLETED

RECORD

LOCATION _____

CASED _____ IN., _____ FT.

RIG UP _____

SAND _____

DRILLING AND REMARKS:

GAS _____

*Top Cha 83446
Total Depth 3520
Swabbing 100 ft.*

OIL _____

TOTAL DEPTH _____

PRODUCTION

1ST 24 HRS. NAT. _____

1ST 24 HRS. AFTER SHOT _____

GAS _____ CU. FT.

DRY HOLE _____

ABANDONED _____

DATE

SEP 26 1928

S. J. LEWIS

192

SCOUT