


STATE OF KANSAS
STATE CORPORATION COMMISSION

Form CP-4

Give All Information Completely
Make Required Affidavit
Mail or Deliver Report to:
Conservation Division
State Corporation Commission
212 No. Market
Wichita, Kansas

WELL PLUGGING RECORD

NORTH

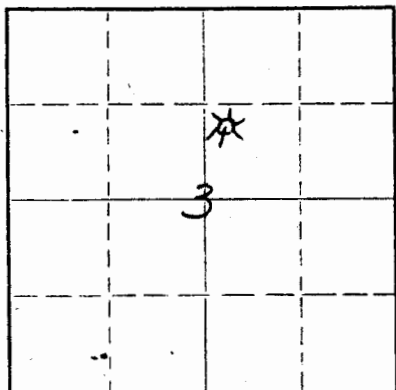

Locate well correctly on above
Section Plat

Cowley County. Sec. 3 Twp 34S Rge. 3 (E) Y
Location as "NE/CNW/SW" or footage from lines NW SW NE
Lease Owner Lloyd Lynd, Jr.
Lease Name S. Bert Well No. 1
Office Address 301 West 11th St, Kansas City, Mo, 64105
Character of Well (completed as Oil, Gas or Dry Hole) Gas
Date well completed August 11 19 67
Application for plugging filed March 20 19 68
Application for plugging approved 19
Plugging commenced 19
Plugging completed 19
Reason for abandonment of well or producing formation Came to water

If a producing well is abandoned, date of last production May 19 67
Was permission obtained from the Conservation Division or its agents before plugging was commenced? Yes

Name of Conservation Agent who supervised plugging of this well

Producing formation Linton ss Depth to top 2620 Bottom 2760 Total Depth of Well 3398 Feet
Show depth and thickness of all water, oil and gas formations.

OIL, GAS OR WATER RECORDS

CASING RECORD

FORMATION	CONTENT	FROM	TO	SIZE	PUT IN	PULLED OUT
<u>Linton ss</u>	<u>Gas</u>	<u>2620</u>	<u>2640</u>	<u>8 5/8</u>	<u>155</u>	<u>None</u>
<u>Bartlesville</u>	<u>Water</u>	<u>2640</u>	<u>2720</u>	<u>5 1/2"</u>	<u>3398</u>	
	<u>Oil</u>	<u>3321</u>	<u>3338</u>			

Describe in detail the manner in which the well was plugged, indicating where the mud fluid was placed and the method or methods used in introducing it into the hole. If cement or other plugs were used, state the character of same and depth placed, from _____ feet to _____ feet for each plug set.

(If additional description is necessary, use BACK of this sheet)

Name of Plugging Contractor _____

Address _____

STATE OF _____, COUNTY OF _____, ss.

_____, (employee of owner) or (owner or operator) of the above-described well, being first duly sworn on oath, says: That I have knowledge of the facts, statements, and matters herein contained and the log of the above-described well as filed and that the same are true and correct. So help me God.

(Signature) _____

(Address) _____

SUBSCRIBED AND SWORN TO before me this _____ day of _____, 19 _____

My commission expires _____

Notary Public.