


WELL LOG BUREAU—KANSAS GEOLOGICAL SOCIETY
508 East Murdock, Wichita, Kansas

Company- **SINCLAIR OIL & GAS CO.**
 Farm- **Weir** No. **1**

SEC. 30 T. 34 R. 3E
 S17 S17 N1
 330 N fr SL, 330 E fr
 W1 N1/4
 County **Cowley**
KANSAS

Total Depth. **3509'**
 Comm. **3-24-55** Comp. **4-4-55**
 Shot or Treated.
 Contractor. **L. C. Smitherman Drlg. Co.**
 Issued. **6-4-55**

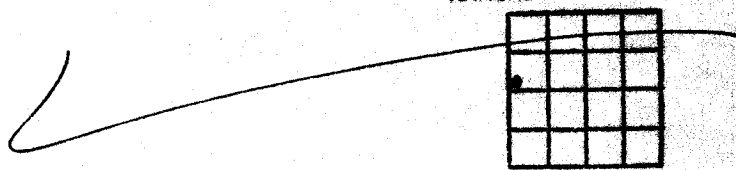

Elevation. **1170'** RB

Production. **I.P. 25 BO**

CASINO:

10" 115' cem w/150 sx
 5 1/2" 3507' cem w/200 sx

Figures Indicate Bottom of Formations

lime	295
shale & lime	375
lime & shale	790
shale & shells	990
lime & shale	1315
shale & lime	1635
lime & shale	1642
shale & sandy lime	1754
lime & shale	2300
sand & shale	2460
lime & shale	2580
shale & lime	2725
sand	2729
Core #1	2759
shale & sand	2830
sand & shale	2913
shale & lime	2946
lime & shale	3020
shale & sand	3066
Core #2	3084
shale	3116
lime	3188
lime & shale	3371
shale	3408
sand	3410
Core #3	3426
sand	3428
Core #4	3448
lime	3509
Total Depth	
Tops; Scout	
Stalnaker	2290
Layton	2725
Cleveland	3065
Bartlesville	3410
Mississippi	3475