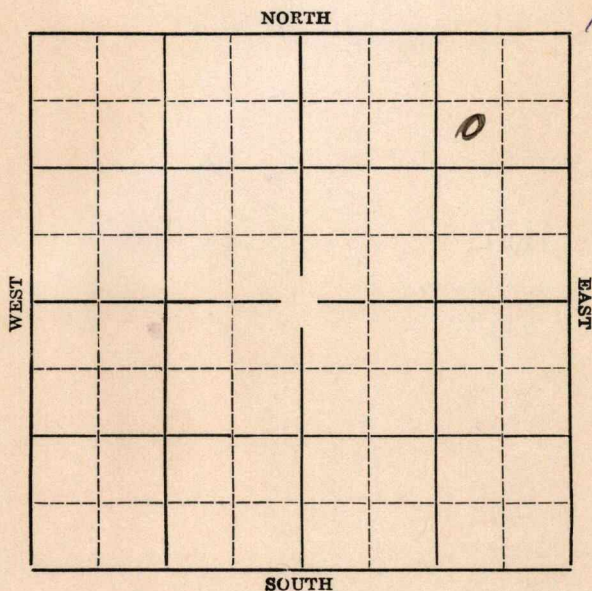



Section 3 Township 34 Range 2-EWell Number 1-Judd (Evelyn Judd Fee)Company Shawver

Map No. _____ Sec. 3 Twp. 34 R. 2EWell No. #1 Judde Farm _____Shawver Company _____990' Ft. from N. Line

_____ Ft. from S. Line

990' Ft. from E. Line

_____ Ft. from W. Line

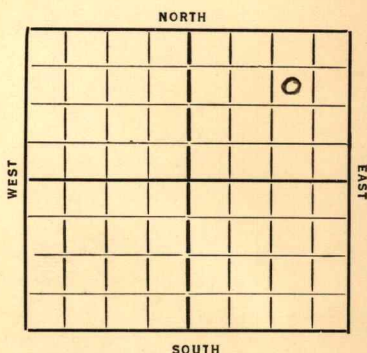Date
1936

REPORT

4/29 R.O.G.5/7 Rig.5/14 Rigging up.5/21 --5/28 Drlg. 400'.6/4 Drlg. 915'.6/11 Drlg. 1535'.6/18 1908'. Cleaning out.6/25 2215'. Under ream 10".7/2 --7/9 Drlg. 2420'.7/16 Drlg. 2865'.7/23 Drlg. 2995'.7/30 Drlg. 3125'.8/6 Chat 3390'. Drlg. 3475'.8/12/36-Chat 3390'.

Sil. 3753'.

Hole full of water 3770'.

T.D. 3775'.

Dry and abandoned.

ABANDONED

KANSAS

Map No. 1 Sec. 3 Twp. 34 R. 2EWell No. 1 QuadeShawver Company

Contractor

SECTION PLAT

			0

990 Ft. from N. Line2 Ft. from S. Line990 Ft. from E. Line

Ft. from W. Line

FIRST REPORT

Location

Rig up

Drilling and Remarks:

ROG

RECORD

Cased _____ in., _____ ft.

Sand _____

Gas _____

Oil _____

Total Depth _____

PRODUCTION

1st 24 hrs. Nat. _____

1st 24 hrs. after shot _____

Gas _____ Cu. Ft.

Dry Hole _____

Abandoned _____

Date

APR 29 1936

192

S. J. LEWIS

Scout

KANSAS

Map No. 1 Sec. 3 Twp. 34 R. 2EWell No. Spadd FeeChawnee Company

Contractor

SECTION PLAT

			0

990 Ft. from N. Line

_____ Ft. from S. Line

990 Ft. from E. Line

_____ Ft. from W. Line

ABANDONED

Location _____

Rig up _____

Drilling and Remarks:

Chad 3390Sil 3753AFW 3770L & H

RECORD

Cased _____ in., _____ ft.

Sand _____

Gas _____

Oil _____

Total Depth 3775

PRODUCTION

1st 24 hrs. Nat. _____

1st 24 hrs. after shot _____

Gas _____ Cu. Ft.

Dry Hole _____

Abandoned _____

Date

AUG 12 1936 19

S. J. LEWIS

Scout