
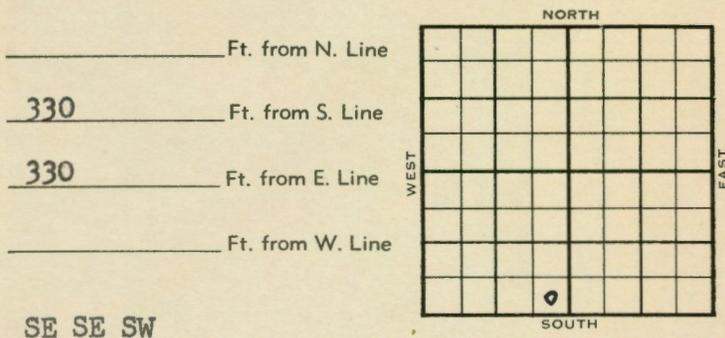


Cowley KANSAS

Section 33 Township 34 Range 4 E
Well No. # 1 Bossi
Company L. C. Smitherman

Cowley KANSAS

SEC. 33 TWP. 34 R. 4E ✓
WELL NO. 1 Bossi FARM
COMPANY L. C. Smitherman
CONTRACTOR

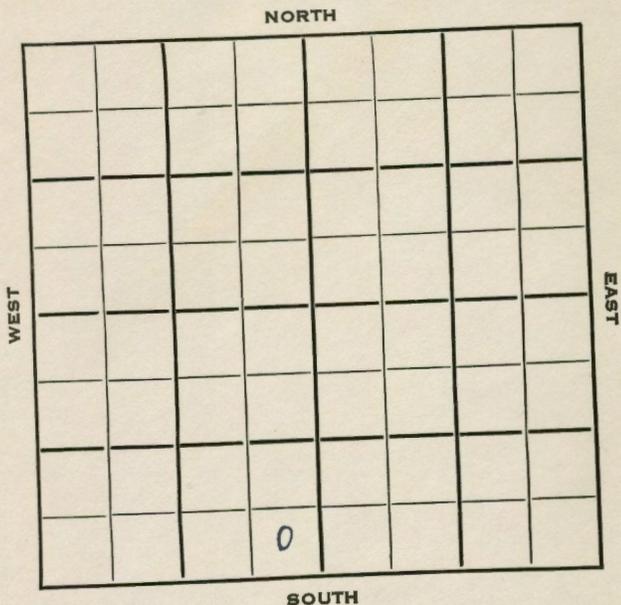

	ELEVATION	REPORT
1953	1066'	
12/22	Spud 11-17-53 D&A TD 3193'	Stal. 1979', Layton 2414', KC 2626', Oswego 2786', Bart 3109', Miss 3167' TD 3192' TD 3193' D&A
		FIRST REPORT + ABANDONED

