

**KANSAS**

Cowley

**KANSAS**

Cowley

Sec. 11 Twp. 34 R. 4E

Section 11 Township 34 Range 4-E

Well No. #1 Weaver

Well No. #1 Weaver Farm

Company E. B. Shaw

E. B. Shaw Company

Miscellaneous


330' Ft. from N. Line

\_\_\_\_\_ Ft. from S. Line


330' Ft. from E. Line

\_\_\_\_\_ Ft. from W. Line

NE SE

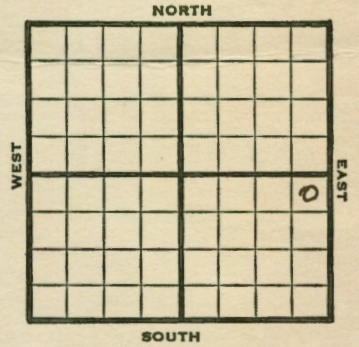

NORTH

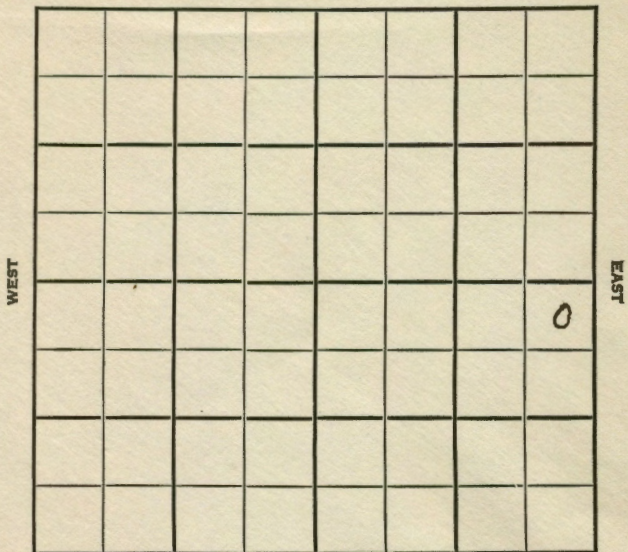

SOUTH

1948

REPORT

5/12

Miss. 3121'

D&A

TD 3128'

**FIRST REPORT**  
↓  
**ABANDONED**

Map No. 2 Sec. 11 Twp. 34 R. 4E

Well No. 1 Weaver

E. B. Shaw Company

**FIRST REPORT**

Contractor

NE SE

SECTION PLAT

330 Ft. from N. Line

\_\_\_\_\_ Ft. from S. Line

330 Ft. from E. Line

\_\_\_\_\_ Ft. from W. Line

			0

**ABANDONED**

Cowley County

Location \_\_\_\_\_

RECORD  
Cased \_\_\_\_\_ in. \_\_\_\_\_ ft.

Rig up \_\_\_\_\_

Sand \_\_\_\_\_

Drilling and Remarks:

Gas \_\_\_\_\_

Miss. 3121

Oil \_\_\_\_\_

Total Depth 2125

D & A

PRODUCTION

1st 24 hrs. Nat. \_\_\_\_\_

1st 24 hrs. after shot \_\_\_\_\_

Gas \_\_\_\_\_ Cu. Ft.

Dry Hole \_\_\_\_\_

Abandoned \_\_\_\_\_

Date

MAY 12 1948 19

S. J. LEWIS Scout