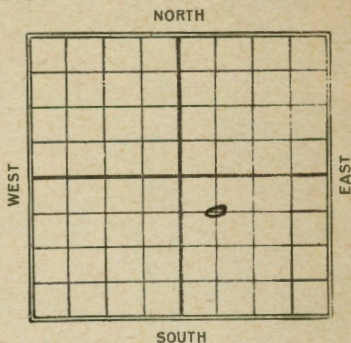


Map No. NE Sec. 14 Twp. 34 R. 4 EWell No. 1- Messner FarmJohnson Ed tool Company
Rosenthal et al660 Ft. from N. Line

Ft. from S. Line


Ft. from E. Line

660 Ft. from W. Line

{OWSS}

REPORT

Date 3/14 Location Location
4/24 Log took @ 700'
7/16 Gas. 1962-70 8 AA Gas
Completed.
8/20 1962-70 - 8 AA gas
1926 {OWSS}
Drilling dupes
4/24 Sand 2140-2144
6 AA Gas

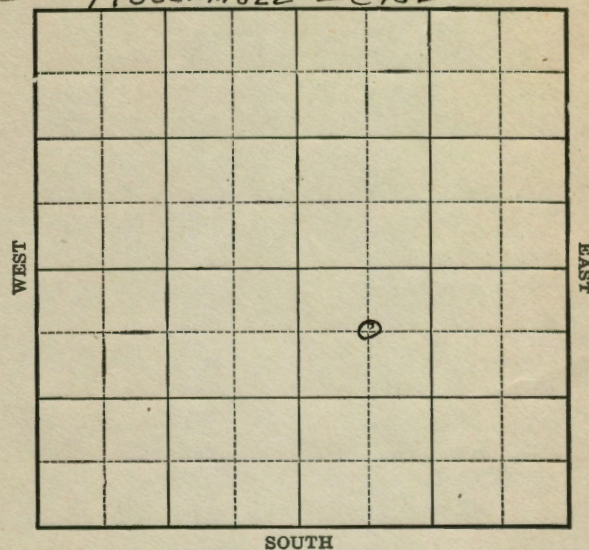Map No. NE Sec. 14 Twp. 34 R. 4 EWell No. 1 Messner FarmJohnson Ed tool Company
Rosenthal et al

{OWSS}

Location

Drilling Remarks:

Rig Up

Drilling Remarks:

RECORD

Cased _____ in. _____ ft.

Sand _____

Gas _____

Oil _____

Total Depth _____

PRODUCTION

1st 24 hrs. Nat. _____

1st 24 hrs. after shot _____

Gas _____ cu. ft.

Dry Hole _____

Abandoned _____

KANSAS 2 Sec. 14 Twp. 34 R. 4E

Well No. #1 Messner

Johnson & Ash Company

Contractor

FIRST REPORT

SECTION PLAT.

660 Ft. from N. Line

Ft. from S. Line

Ft. from E. Line

660 Ft. from W. Line

		83140	
		17	

Location

RECORD

Cased in., ft.

Rig up

Sand

Drilling and Remarks:

Gas

Oil

Total Depth

PRODUCTION

1st 24 hrs. Nat.

1st 24 hrs. after shot

Gas Cu. Ft.

Dry Hole

Abandoned

Date

MAR 14 1924

M. A. BENEAR

192

Scout

2 KANSAS Sec. 14 Twp. 34 R. 4E

Well No. #1 Messner

Johnson & Ash Company

Contractor

COMPLETED

SECTION PLAT.

660 Ft. from N. Line

Ft. from S. Line

Ft. from E. Line

660 Ft. from W. Line

		0	

Location

RECORD

Cased in., ft.

Rig up

Sand

Drilling and Remarks:

Gas

Oil

Total Depth

PRODUCTION

1st 24 hrs. Nat.

1st 24 hrs. after shot

Gas Cu. Ft.

Dry Hole

Abandoned

Date

AUG 26 1924

M. A. BENEAR

192

Scout

K2 COWLEY Co
Map No. KANSAS Sec. 14 Twp. 34 R. 4Well No. 1 Hahlemier
Rosenhall et al Company
Contractor

COMPLETED

SECTION PLAT

660 Ft. from N. Line
Ft. from S. Line
Ft. from E. Line
660 Ft. from W. Line

		0	

Location -----

Rig up -----

Drilling and Remarks:

S&S 2122-2127

RECORD

Cased ----- in., ----- ft.

Sand 2140-2144

Gas -----

Oil -----

Total Depth 2144

PRODUCTION

1st 24 hrs. Nat. -----

1st 24 hrs. after shot -----

Gas 6 M Cu. Ft.

Dry Hole -----

Abandoned -----

Date

APR 21 1926

CHAS. L. SHERWOOD

192

Scout

K2 COWLEY Co
Map No. KANSAS Sec. 14 Twp. 34 R. 4Well No. 1 Hahlemier
Rosenhall et al Company
Contractor

FIRST REPORTS

SECTION PLAT

660 Ft. from N. Line
Ft. from S. Line
Ft. from E. Line
660 Ft. from W. Line

		0	

Old Hole Super-

Location -----

Rig up -----

Drilling and Remarks:

Old 20 1970'

SR 8"

20 2005'

RECORD

Cased ----- in., ----- ft.

Sand -----

Gas -----

Oil -----

Total Depth -----

PRODUCTION

1st 24 hrs. Nat. -----

1st 24 hrs. after shot -----

Gas ----- Cu. Ft.

Dry Hole -----

Abandoned -----

Date

MAR 11 1926

CHAS. L. SHERWOOD

192

Scout