


Map No. Kans Sec. 17 Twp. 34 R. 4^E

Well No. 2 Goff Farm

Kanotic Refg Company

NORTH

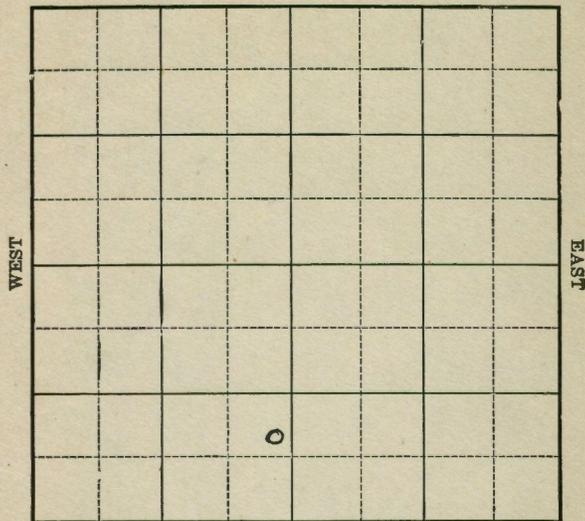

SOUTH

Location _____

Drilling Remarks _____

Rig Up _____

Drilling Remarks _____

RECORD

Cased _____ in. _____ ft.

Sand _____

Gas _____

Oil _____

Total Depth _____

PRODUCTION

1st 24 hrs. Nat. _____

1st. 24 hrs. after shot _____

Gas _____ cu. ft.

Dry Hole _____

Abandoned _____

Map No. Kans Sec. 17 Twp. 34 R. 4

Well No. 2 Goff Farm

Kanotic Company


NORTH

_____ Ft. from N. Line

950 Ft. from S. Line

250 Ft. from E. Line

_____ Ft. from W. Line

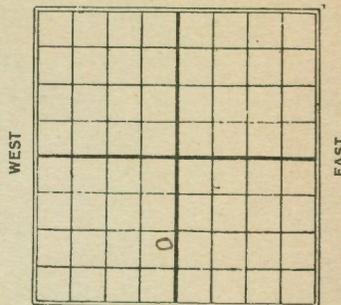

SOUTH

Date
1924

REPORT

12/11 Location

12/17 Gas sand 642-657

1/2 M Gas

Completed for gas well

12/30 642-57 1/2 m Gas

Map No. 2 Sec. 17 Twp. 34 R. 4

Well No. 2 Gas
Kanotex Company

Contractor

FIRST REPORT

SECTION PLAT

_____ Ft. from N. Line
950 Ft. from S. Line
250 Ft. from E. Line
_____ Ft. from W. Line

Location LL
Rig up _____
Drilling and Remarks:

RECORD
Cased _____ in., _____ ft.
Sand _____
Gas _____
Oil _____
Total Depth _____

PRODUCTION
1st 24 hrs. Nat. _____
1st 24 hrs. after shot _____
Gas _____ Cu. Ft.
Dry Hole _____
Abandoned _____

Date
DEC 11 1924
_____ 192_____

M. A. BENEAR
Scout

Map No. 2 Sec. 17 Twp. 34 R. 4 E

Well No. 2 Gas
Kanotex Ref. Company

Contractor

COMPLETED

SECTION PLAT

_____ Ft. from N. Line
950 Ft. from S. Line
250 Ft. from E. Line
_____ Ft. from W. Line

Location _____
Rig up _____
Drilling and Remarks:

Gas sand
642-57
1/2 M Gas
Comp. for Gas
Well

RECORD
Cased _____ in., _____ ft.
Sand _____
Gas _____
Oil _____
Total Depth _____

PRODUCTION
1st 24 hrs. Nat. _____
1st 24 hrs. after shot _____
Gas _____ Cu. Ft.
Dry Hole _____
Abandoned _____

Date
12-30 1924

M. A. B.
Scout