


Map No. **KANSAS** Sec. 14 Twp. 34^S R. 4^E

Well No. 1- Messner Farm

Company

NORTH

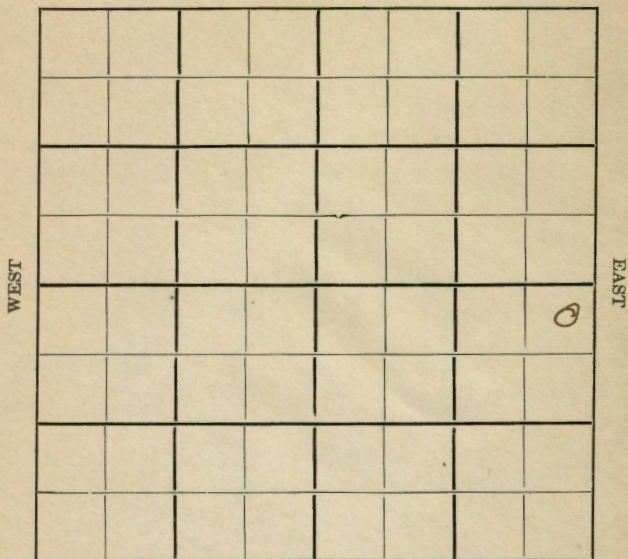

SOUTH

Location.....
Drilling Remarks.....

Rig Up.....
Drilling Remarks.....

RECORD

Cased.....in.....ft.
Sand.....
Gas.....
Oil.....
Total Depth.....

PRODUCTION


1st 24 hrs. Nat.....
1st 24 hrs. after shot.....
Gas.....cu. ft.....
Dry Hole.....
Abandoned.....

Map No.....Sec.....Twp.....R.....

Well No.....Farm

Company

NORTH

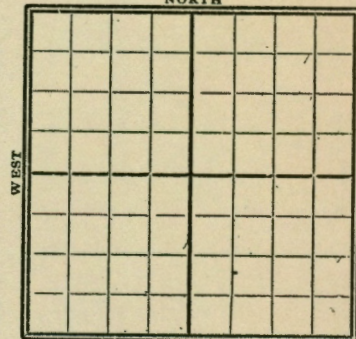

SOUTH

.....Ft. from N. Line

.....Ft. from S. Line

.....Ft. from E. Line

.....Ft. from W. Line

1920

Date

REPORT

Gypsy Records

5/6

Abd T.D. 2195'

MAP No. K2 KANSAS SEC. 14 TWP. 34S R. 1E

WELL No. 1 Messner

COMPANY

CONTRACTOR

SECTION PLAT

			0

ABANDONED

FT. FROM N. LINE

FT. FROM S. LINE

FT. FROM E. LINE

FT. FROM W. LINE

no record

LOCATION

RIG UP

DRILLING AND REMARKS:

RECORD

CASED IN. FT.

SAND

GAS

OIL

TOTAL DEPTH 2195

PRODUCTION

1ST 24 HRS. NAT.

1ST 24 HRS. AFTER SHOT

GAS CU. FT.

DRY HOLE ☒

ABANDONED ☒

DATE

May 6 1920

SCOUT