

Summer

KANSAS

SECTION 4 TOWNSHIP 34 RANGE 2 E

WELL NO. #1 Robbins

COMPANY Stelbar

NORTH

4

0							

SOUTH

WEST

EAST

Sumner

KANSAS

SEC. 4	TWP. 34	R. 2E
-----------	------------	----------

WELL NO.

#1 Robbins

FARM

COMPANY

Stelbar

CONTRACTOR

McKnab & Lindsay


_____ Ft. from N. Line

_____ Ft. from S. Line

_____ Ft. from E. Line

_____ Ft. from W. Line

NW NW NW

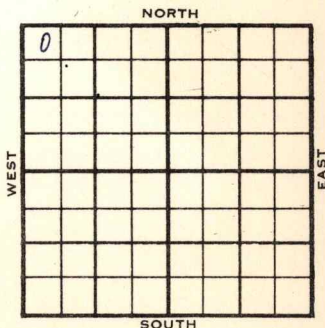

	ELEVATION	REPORT
1955		
12-28	Comm. 12-23555 8" @ 100/80 Drlg. 1801	
1956		
1-11	DST 3414-30 op 1 hr. rec. 25' o&gcm, 120' ocmsw, 1240/12" D & A Layton 2773 KC 2955 Oswego 3147 M. 3414 TD 3430'	

ABANDONED

County Sumner Elev. _____
 Sec. 4 Twp. 34 Rge. 2E
 Company Stelbar
 Farm Name Robbins No. 1

TOPS	DEPTH	LOG	DATUM	Loc. in Sec.
Anh.				NW NW NW
Tp.				
H.				
Tr. <u>Layton</u>	<u>2773</u>			
Dg.				
Bl.				
L.				
K.C.	<u>2955</u>			Geol. _____
B.K.C. <u>Domagala</u>	<u>3147</u>			Contr. _____
Ce.				McKnab &
C.				Lindsay
M.	<u>3414</u>			Pool
M.				
K.				
Mz.				
Mq.				
V.				
S.				
S.				
A.				
R.				
Pe.				
G.				
T.D.	<u>3430</u>			



Date Comm. 12-23-55 JAN 11 1956
8" @ 100/80 DST 3414-30 open 1 hr.
rec. 25' o & gcm 120' ocmsw 1240/12"

D & A

County

Sumner

Elev.

Sec.

4

Twp.

34

Rge.

2E

Company

Stelbar

Farm Name

Robbins

No.

1

TOPS

DEPTH

LOG

DATUM

Loc. in Sec.

Anh.

Tp.

H.

Tr.

Dg.

Bl.

L.

K.C.

B.K.C.

Ce.

C.

M.

M.

K.

Mz.

Mq.

V.

S.

S.

A.

R.

Pc.

G.

T.D.

Geol.

Contr.

McKnab &

Lindsay

Pool

6

DEC 28 '55

FIRST REPORT

Date Comm.

12-23-55

8" @ 100/80 drlg. 1801

Co.

Lse.

No.

Sec.

T.

R.