

Cowley

O.W.W.O.


KANSAS

Section 2 Township 34 Range 5E

Well No. #1 Albright

Company Glickman Oil Company *Bob Jones*

NORTH

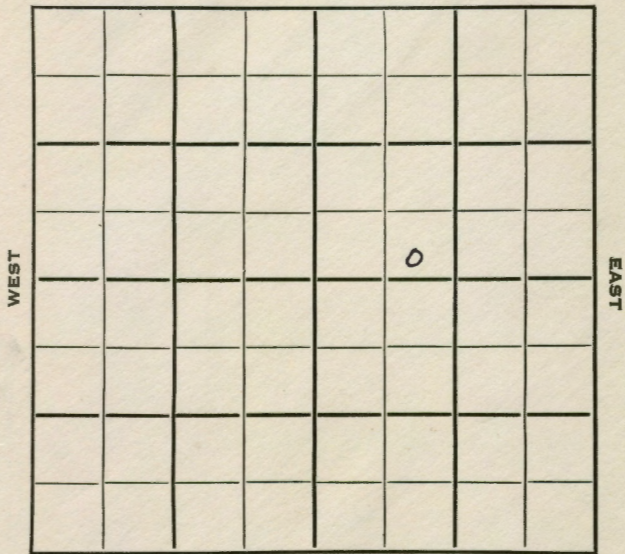

SOUTH

O.W.W.O.

Cowley

KANSAS



Sec. 2 Twp. 34 R. 5E

Well No. #1 Albright Farm

Glickman Oil *Bob Jones* Company

Uhl Drilg. Contractor

Ft. from N. Line


330 Ft. from S. Line

Ft. from E. Line

990 Ft. from W. Line

SE SW NE

NORTH

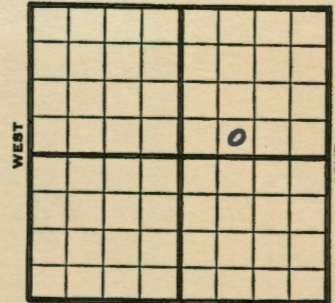

SOUTH

1953 1258' REPORT

3/11 ~~MX~~ Miss 3126' TD 3141'  
D & A

**FIRST REPORT**  
+  
**ABANDONED**

1956

O.W.W.O.

5-23 OTD 3142  
WORT

Log tops: Layton 2365', KC 2524',  
Marm 2754', Miss. ~~32~~ 3126'.

8-8 CO 3142

~~FIRST REPORT~~

5 1/2" @ 3100  
Pipe parted  
B & A  
TD 3142'

**ABANDONED**

County Cowley State Kansas

Sec. 2 (Blk. Twp.) 34 (Sur. Rge.) 5E Map No.

Operator Glickman Oil

Well No. 1 Farm Albright

Elev. \_\_\_\_\_ Location SE SW NE



330 Ft. From S Line NE

990 Ft. From W Line Quarter

1st. Report MAR 11 1953

Completion MAR 11 1953

Remarks \_\_\_\_\_

Uhl Drlg. - Contr.

Spudding Date \_\_\_\_\_

Drlg. Data \_\_\_\_\_

Miss/ 3126 TD 3141 D & A

J. G. McGEHEE

~~O.W.W.O.~~

County Cowley Elev. 1258  
 Sec. 2 Twp. 34 Rgs. 5E  
 Company Bob Jones  
 FarmName Albright No. 1

TOPS	DEPTH	LOG	DATUM	Loc. in Sec.
Anh.				SE SW NE
TP.				
H.				
Tr.				
Dg.				
Bl. <u>Layton</u>		<u>2365</u>		Geol.
L.		<u>2524</u>		
K.C.				Contr.
B.K.C. <u>Marm</u>		<u>2754</u>		
Ce.				Kriswell
C.				
M.				Pool
M. <u>Miss</u>		<u>3126</u>		
K.				Wildcat
Mz.				
Me.				
V.				
S.				
S.				
A.				
R.				
PE.				ABANDONED
G.				
TD.	<u>3142</u>			

Date Comm. AUG 8 '56  
 OTD 3142 WORT MAY 29 '56 WOR JUN 6 '56  
 WOR JUN 13 '56 JUN 20 '56 JUN 27 '56  
JUL 3 '56 JUL 11 '56 WOR JUL 18 '56 JUL 25 '56  
 CO ~~RD~~ 3142 5 1/2 @ 3100 AUG 1 '56  
 MIST AUG 13 '56 Pipe Parted.  
 D & A

O.W.W.O.

O.W.O.

County Cowley Elev. 1258  
 Sec. 2 Twp. 34 Rgs. 5E  
 Company Bob Jones  
 FarmName Albright No. 1

TOPS	DEPTH	LOG	DATUM	Loc. in Sec.
Anh.				SE SW NE
TP.				
H.				
Tr.				
Dg.				
Bl. <u>Layton</u>		<u>2365</u>		Geol.
L.		<u>2524</u>		
K.C.				Contr.
B.K.C. <u>Marm</u>		<u>2754</u>		
Ce.				Kriswell
C.				
M.				Pool
M. <u>Miss</u>		<u>3126</u>		
K.				Wildcat
Mz.				
Me.				
V.				
S.				
S.				
A.				
R.				
PE.				FIRST REPORT
G.				
TD.				MAY 23 '56

Date Comm. OTD 3142 WORT

JUN 1 1956

R.G.