

DX 78-1


Cowley

KANSAS

Section 2 Township 34 Range 5E

Well No. #2 Albright "A"

Company Harbor Drlg.

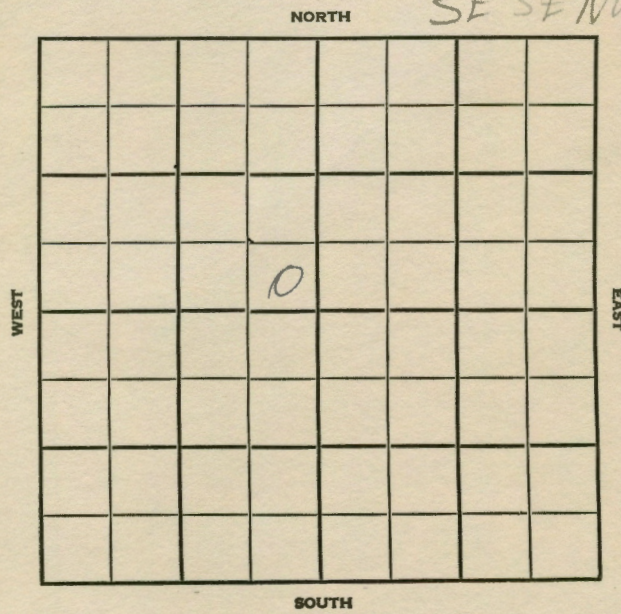

County Cowley Elev. _____
 Sec. 2 Twp. 34 Rge. 5E
 Company Harbor Drlg.
 FarmName Albright "A" No. 2

Co.

Loc.

No.

Sec.

T.

R.

TOPS	DEPTH	LOG	DATUM	Loc. in Sec.
Anh.				SE SE NW
TP.				280' Isl x 2310
H.				fwl NW/4
Tr.				
Dg.				
Bl.				
L.				Geol.
K.C.				
B.K.C.				Contr.
Ce.				H.&M. Drlg.
C.				
M.				Pool
Mz.				Albright
Mo.				
V.				
S.				
S.				
A.				
R.				
Pe.				
G.				
TD.				

FIRST REPORT

Date Comm.

MIRT

NOV 5 1956

D.R.

County Cowley Elev. 1236
 Sec. 2 Twp. 34 Rge. 5E
 Company Harbor Drlg.
 FarmName Albright "A" No. 2

TOPS	DEPTH	LOG	DATUM	Loc. in Sec.
Anh.				SE SE NW
TP.				280' Isl x 2310
H.				fwl NW/4
Tr.				
Dg.				
Bl.				
L.				Geol.
K.C.				
B.K.C.				Contr.
Ce.				H.&M. Drlg.
C.				
M.	<u>- Cg</u>	<u>3113</u>		Pool
M.	<u>chat</u>	<u>3120</u>		Albright
K.				
Mz.				
Mo.				
V.				
S.				
S.				
A.				
R.				
Pe.				
G.				
TD.	<u>3179</u>			

COMPLETE

Date Comm.

MIRT NOV 21 '56 11-14-56 85/8 86/65

D 2135 NOV 28 '56 DST 3121-27 04

1hr 300' GIR rec 35' 0.66M

BHP 930/130 5 1/2 3177/ CO

56/3120-27 tot 550 fwt

DEC 5 '56 Frac & 8 Boph TR

wtr 10 hrs 108 DEC 12 '56 DEC 19 '56

P. 65 B0 + 10 BW 12 hrs

P. 25 Bopd + 15 1/2 wtr