

DX 78-1


Cowley

KANSAS

Section 2 Township 34 Range 5E

Well No. #3 Brown

Company Sun Oil Co.

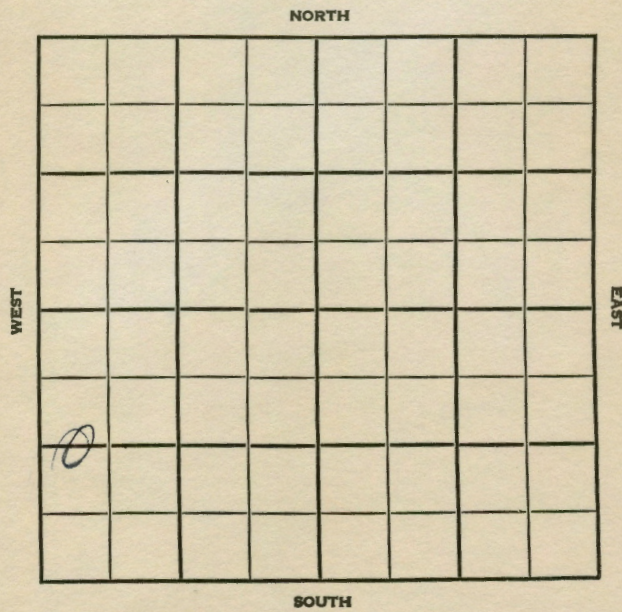

FORM 513 SUNRAY

County Cowley Elev. 1175
 Sec. 2 Twp. 34 Rge. 5E
 Company Sun Oil Co.
 Farm Name Brown No. 3

TOPS	DEPTH	LOG	DATUM	Loc. in Sec.
Anh.				C W/2 W/2 SW
Tp.				
H.				
Tr.				
Dg.				
Bl.				
L. <u>275d</u>	<u>2299</u>			Geol.
K.C.	<u>2468</u>			Contr.
B.K.C.	<u>2607</u>			
Ge. <u>Harm</u>	<u>2624</u>			
C.e.	<u>2821</u>			
M. <u>chert</u>	<u>3066</u>			Pool
M.				<u>Albright</u>
K.				
Mz.				
Me.				
V.				
S.				
S.				
A.				
R.				
Pe.				
G.				
TD	<u>3072</u>			

Date Comm.

Location NOV 21 '56 ✓ NOV 28 '56 ✓ DEC 5 '56 11-29

-56 898 88/90 MD 2275 DEC 12 '56

5 1/2 3069/1125 DD 3096 TD

B 20 60 + 6 Gwph 4 hrs To Fla.

DEC 19 '56 6 X 6 \$ 61 B0 + 10 40

Wtr 22 hrs POP DEC 26 '56 P. 25

Bord + 12 Bwph

FORM 513 SUNRAY

County Cowley Elev. 1175
 Sec. 2 Twp. 34 Rge. 5E
 Company Sun Oil Co.
 Farm Name Brown No. 3

TOPS	DEPTH	LOG	DATUM	Loc. in Sec.
Anh.				C W/2 W/2 SW
Tp.				
H.				
Tr.				
Dg.				
Bl.				
L.				
K.C.				Geol.
B.K.C.				Contr.
Ce.				
C.				
M.				
M.				Pool
K.				<u>Albright</u>
Mz.				
Me.				
V.				
S.				
A.				
R.				
Pe.				
G.				
TD				

Date Comm.

Location

NOV 21 '56

D.R.

2A