


Section 3 Township 34 Range 5E
 Well No. #1 Brown
 Company H & M & CRA

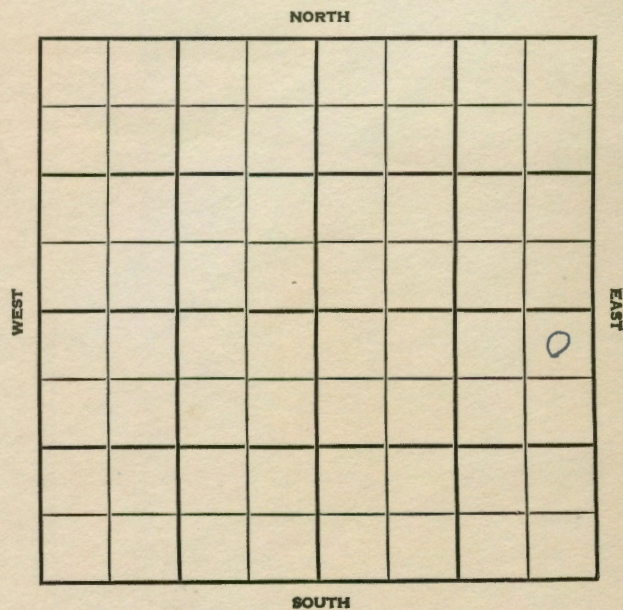

SEC.

3

TWP.

34

R.

5E

WELL NO.

#1 Brown

COMPANY

H & M & CRA

CONTRACTOR

Co. Tools

Albright


FT. FROM N. LINE

FT. FROM S. LINE

FT. FROM E. LINE

FT. FROM W. LINE

NE NE SE

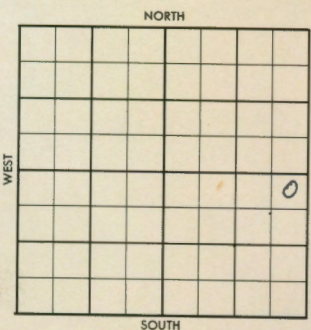

1956

ELEVATION

1229'

REPORT

6-13

Comm. 6-7-56

8" @ 88 w/70

Drlg. 2037'

7-18

DST 2359-67 op 1 hr, rec. 50' mdy GCO
 600' SW, 820/20".

5 1/2" @ 3122 w/75

CO 3136

B/ 2/3 mdy oil

B/ 1 BOPH, no/wtr., 6 hrs.

Flw 50 BO, no time

P/ 25 BOPD no/wtr.

Lay 2359'; Osw. 2744'; C. 3115';

M. Chat 3121';

TD 3136'

COMPLETED

County Cowley Elev. 5E
 Sec. 3 Twp. 34 Rge. 5E
 Company H & M & CRA
 FarmName Brown No. 1

TOPS	DEPTH	LOG	DATUM	Loc. in Sec.
Anh.				NE NE SE
TP.				
H.				
Tr.				
Dg.				
Bl.				
L.				
K.C.				Geol.
B.K.C.				Contr.
Ce.				Co. tools
C.				
M.				Pool
M.				Albright
K.				
Mz.				
Me.				
V.				
S.				
S.				
A.				
R.				
Pe.				
G.				
T.D.				

Date Comm. 6-7-56
8" @ 88/70 drlg. 2037

FIRST REPORT
 JUN 13 '56

County Cowley Elev. 1229
 Sec. 3 Twp. 34 Rge. 5E
 Company H & M & CRA
 FarmName Brown No. 1

TOPS	DEPTH	LOG	DATUM	Loc. in Sec.
Anh.				NE NE SE
TP.				
H.	<u>684</u>	<u>2359</u>		
Tr.				
Dg.	<u>etc</u>			
Bl.				
L.	<u>OSW</u>	<u>2744</u>		
K.C.				Geol.
B.K.C.				Contr.
Ce.				Co. tools
C.		<u>3115</u>		
M.	<u>chat</u>	<u>3121</u>		Pool
M.				Albright
K.				
Mz.				
Me.				
V.				
S.				
S.				
A.				
R.				
Pe.				
G.				
T.D.		<u>3136</u>		

Date Comm. 6-7-56
8" @ 88/70 drlg. 2037 JUN 20 '56

DST 2359-67 1hr. acc 50'
Mdy GCOil + 600' SW 820/20"
5 1/2 @ 3122/75 JUN 27 '56 CO 3136
1 2/3 Mdy oil 1 Boph no/w
6 hrs Frac Flw 50 BO no
time T & R JUL 3 '56 JUL 11 '56
JUL 18 '56 P. 25 Bopd no/w

COMPLETE

JUL 18 1956