


Cowley

KANSAS

SECTION 3 TOWNSHIP 34 RANGE 5E

WELL NO. #3 Brown "B"

COMPANY Hammer & MacLean & CRA

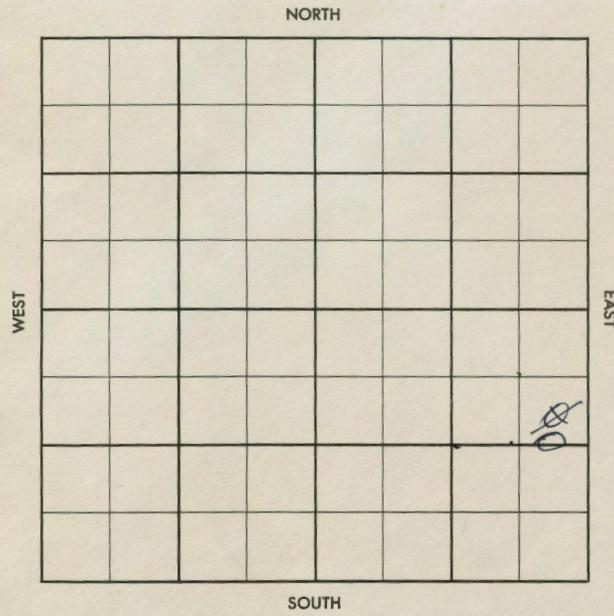

County **Cowley** Elev. \_\_\_\_\_  
Sec. **3** Twp. **34S** Rge. **5E**  
Company **Hammer & MacLean & C. R. A.**  
FarmName **Brown "R"** No. **3**

TOPS	DEPTH	LOG	DATUM	Loc. in Sec.
Anh.				<b>SE NE SE</b>
Tp.				
H.				
Tr.				
Dg.				
Bl.				
L.				
K.C.				
B.K.C.				
Ce.				
C.				
M.				
M.				
K.				
Mz.				
Me				
V.				
S.				
S.				
A.				
R.				
PE.				
G.				
TD				

FIRST REPORT  
OCT 3 '56

Date Comm. **MIRT**

OCT 1 1956

R.G.

**CORRECTION**

County **Cowley** Elev. **1152'**  
Sec. **3** Twp. **34S** Rge. **5E**  
Company **Hammer & MacLean & C. R. A.**  
FarmName **Brown "R"** No. **3**

TOPS	DEPTH	LOG	DATUM	Loc. in Sec.
Anh.				<b>E2 E2 SE</b>
Tp.				<b>SE NE SE</b>
H. <b>Lay</b>	<b>2284</b>			<b>1320 FSL</b>
Tr. <b>chkd</b>	<b>2573</b>			<b>100 FFL of SE 4</b>
Dg. <b>OSW</b>	<b>2668</b>			
Bl. <b>ce</b>	<b>2803</b>			
L.				
K.C.				
B.K.C.				
Ce.				
C.				
M. <b>chat</b>	<b>3052</b>			
M. <b>LI</b>	<b>3066</b>			
K.				
Mz.				
Me				
V.				
S.				
S.				
A.				
R.				
PE.				
G.				
TD	<b>3067</b>			

COMPLETE

NOV 15 '56

Date Comm. **MIRT**

OCT 10 '56 **10-4-56 858 66/70**  
D 2600 OCT 17 '56 **5 1/2 @ 3055'**  
OCT 24 '56 **CO 3067 F1AC 6 X 6**  
\$ rate 10 Boph 10 40 W5  
OCT 31 '56 **wo pump NOV 7 '56**  
P. 10 Boph 10 hrs 3 1/2 wtr  
NOV 13 '56 **P. 56 Bo nolw 24 hrs**