


KANSAS

Section 3 Township 34 Range 5E

Well No. #1 Hunt

Company ~~Criswell~~ G. D. Smith ERMAN

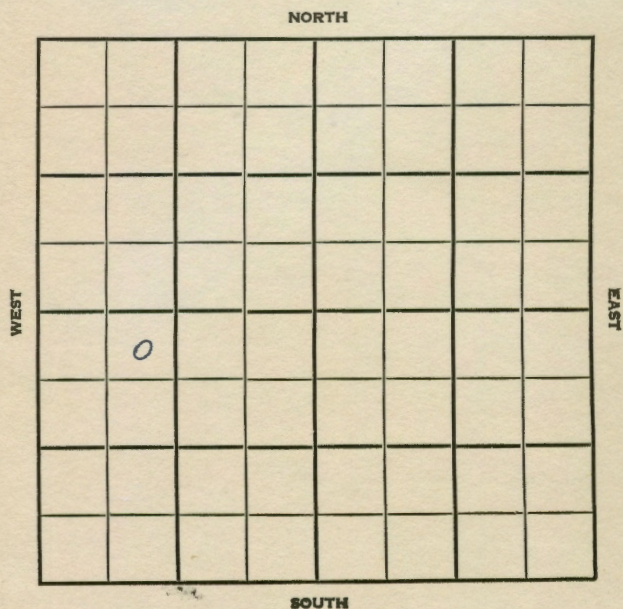

SEC.	TWP.	R.
3	34	5E
WELL NO.		
#1 Hunt		
COMPANY	FARM	
G.D. SMITH & SONS Criswell		
CONTRACTOR		


Semi-Wildcat

_____ FT. FROM N. LINE

_____ FT. FROM S. LINE

_____ FT. FROM E. LINE

_____ FT. FROM W. LINE

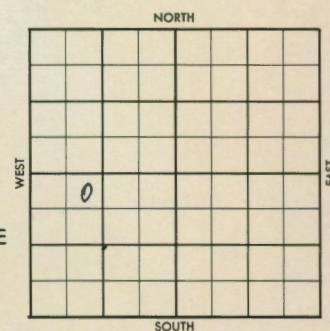

NE NW SW

SDX - Offset

Kriswell-Support

1956

ELEVATION 1120'

REPORT

8-8	Location
8-16	"
8-23	Spud 8-17-56 8 5/8" @ 100 Drlg. 2300' (TITE HOLE)
8-29	DST 3039-50 op 30 min. rec. 45' mud, 60/20". D&A Lay. 2276'; Osw. 2673'; M.Chat 3038'; M. Li. 3052'; TD 3060'

ABANDONED

County Cowley Elev. _____Sec. 3 Twp. 34 Rge. 5ECompany CriswellFarm Name Hunt No. 1

TOPS	DEPTH	LOG	DATUM	Loc. in Sec.
Anh.				NE NW SW
TP.				
H.				
Tr.				
Dg.				
Bl.				
L.				
K.C.				Geol.
B.K.C.				Contr.
Ce.				
C.				
M.				
M.				Pool
K.				Semi-Wildcat
Mz.				
Me.				
V.				
S.				
S.				
A.				
R.				
Pe.				
G.				
TD				

Date Comm. _____

SUNRAY & Kriswell support

Location _____

AUG 1 9 1956

R.G.

CORRECTION

County Cowley Elev. 1120Sec. 3 Twp. 34 Rge. 5ECompany Criswell G.D. SmithermanFarm Name Hunt No. 1

	DEPTH	LOG	DATUM	Loc. in Sec.
H.	<u>2276</u>			NE NW SW
Tr.	<u>2273</u>			
Dg.				
Bl.				
L.				
K.C.				Geol.
B.K.C.				Contr.
Ce.				
C.				
M.	<u>chat</u>	<u>3038</u>		
M.	<u>41</u>	<u>3052</u>		
K.				
Mz.				Pool
Me.				Semi-Wildcat
V.				
S.				
S.				
A.				
R.				
Pe.				
G.				
TD	<u>3060</u>			ABANDONED

Date Comm. _____

Title

Kriswell support

Location _____

AUG 18 '56

AUG 22 '56

8-17-56

85/8 80/100 ID 2300 AUG 29 '56

OST 3039-50 30" sec 45'

Md (550) 60/20"

P&A