



FORM 51 Cowley O.W.W.O. KANSAS
 Section 2 Township 34 Range 5E
 Well No. #1 Albright
 Company Glickman Oil Company *Bob Jones*

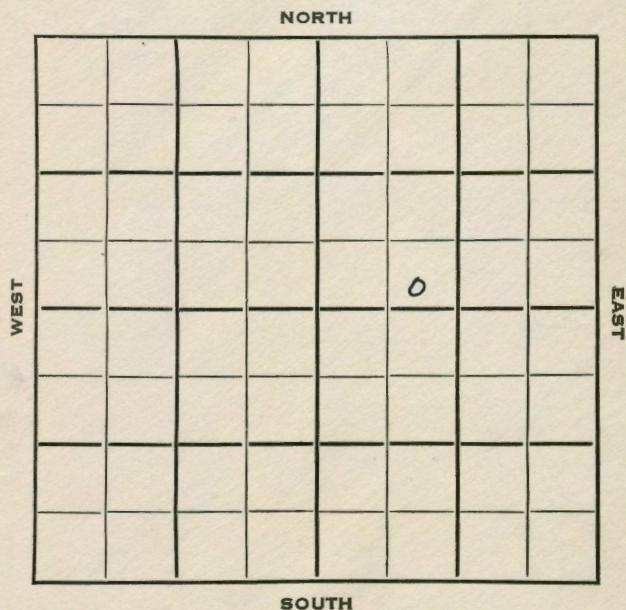

FORM 252-B O.W.W.O. Cowley KANSAS ✓
 Sec. 2 Twp. 34 R. 5E
 Well No. #1 Albright Farm
Glickman Oil *Bob Jones* Company
Uhl Drlg. Contractor

Ft. from N. Line
330 Ft. from S. Line
 Ft. from E. Line
990 Ft. from W. Line

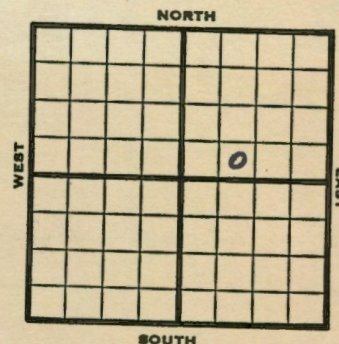


SE SW NE

1953 1258' REPORT
 3/11 ~~MT~~ Miss 3126' TD 3141'
 D & A
FIRST REPORT
ABANDONED

1956 O.W.W.O.
 5-23 OTD 3142
 WORT
 Log tops: Layton 2365', KC 2524',
 Marm 2754', Miss. ~~32~~ 3126'.
 8-8 CO 3142
~~FIRST REPORT~~
 5 1/2" @ 3100
 Pipe parted
 D & A
 TD 3142'
ABANDONED

County **Cowley** State **Kansas**
 Sec. **2** (Blk. **34** (Sur. **5E** Map No.
 Operator **Glickman Oil**
 Well No. **1** Farm **Albright**
 Elev. _____ Location **SE SW NE**

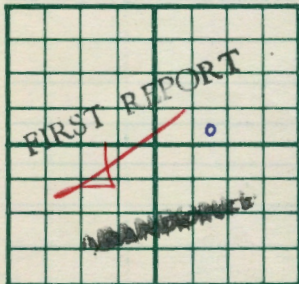

330 Ft. From **S** Line **NE**
990 Ft. From **W** Line **Quarter**
 1st. Report **MAR 11 1953**
 Completion **MAR 11 1953**
 Remarks
Uhl Drlg. - Contr.
 Spudding Date _____

Drig. Data

Miss/ 3126 TD 3141 D & A

J. G. McGEHEE

O.W.W.O.

FORM 513 SUNRAY

OWWO

County Cowley Elev. 1258
 Sec. 2 Twp. 34 Rge. 5E
 Company Bob Jones
 FarmName Albright No. 1

TOPS	DEPTH	LOG	DATUM	Loc. in Sec.
Anh.				SE SW NE
Tp.				
H.				
Tr.				
Dg.				
BLT				
L. <u>Layton</u>		<u>2365</u>		Geol.
K.C.		<u>2524</u>		Contr.
B.K.C.				<u>Kriswell</u>
Ce. <u>Marm</u>		<u>2754</u>		Pool
C.				<u>Wildcat</u>
M. <u>Miss</u>		<u>3126</u>		
K.				
Mz.				
Mo.				
V.				
S.				
A.				
R.				
Pe.				
G.				
T.D.				

FIRST REPORT
 MAY 23 '56

Date Comm. OTD 3142 WORT

after 1 mil

G.R.

FORM 513 SUNRAY

OWWO

County Cowley Elev. 1258
 Sec. 2 Twp. 34 Rge. 5E
 Company Bob Jones
 FarmName Albright No. 1

TOPS	DEPTH	LOG	DATUM	Loc. in Sec.
Anh.				SE SW NE
Tp.				
H.				
Tr.				
Dg.				
BLT				
L. <u>Layton</u>		<u>2365</u>		Geol.
K.C.		<u>2524</u>		Contr.
B.K.C.				<u>Kriswell</u>
Ce. <u>Marm</u>		<u>2754</u>		Pool
C.				<u>Wildcat</u>
M. <u>Miss</u>		<u>3126</u>		
K.				
Mz.				
Mo.				
V.				
S.				
A.				
R.				
Pe.				
G.				
T.D.				

ABANDONED

Date Comm. OTD 3142 WORT AUG 8 '56

Wd.R JUN 13 '56 JUN 20 '56 JUN 27 '56
JUL 3 '56 JUL 11 '56 WOR JUL 18 '56 JUL 25 '56
CO 3142 5 1/2 @ 3100 AUG 1 '56
MIST AUG 8 '56 Pipe Parted.

D&A