


Cowley

KANSAS

SECTION 2 TOWNSHIP 34 RANGE 5E

WELL NO. #3 Albright

COMPANY Bob Jones

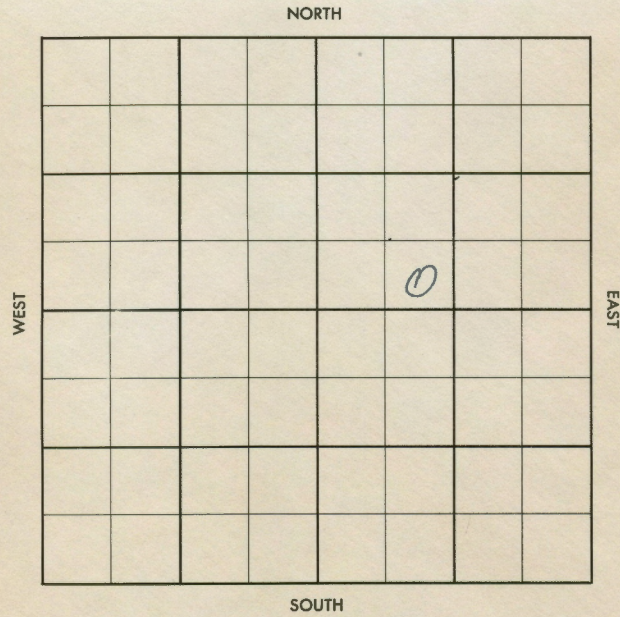

County Cowley Elev. 1262
 Sec. 2 Twp. 31 Rge. 5E
 Company Bob Jones
 FarmName Albright No. 3

TOPS	DEPTH	LOG	DATUM	Loc. in Sec.
Anh.				SE SW NE
TP.				125' NW
H.				
Tr.				
Dg.				
Bl.				
L.				Geol.
K.C.				Contr.
B.K.C.				Criswell
Ce.				
C.				
M.				
M.				
K.				Pool
Mz.				Albright
Me.				
V.				
S.				
S.				
A.				
R.				
Pe.				
G.				
TD				

Date Comm. 1-9-57

8" @ 81/80 drlg. 2/45

29

County Cowley Elev. 1262
 Sec. 2 Twp. 31 Rge. 5E
 Company Bob Jones
 FarmName Albright No. 3

TOPS	DEPTH	LOG	DATUM	Loc. in Sec.
Anh.				SE SW NE
TP.				125' NW
H.				
Tr.				
Dg.				
Bl.	245d	2376		
L.				Geol.
K.C.	25w	2732		Contr.
B.K.C.				Criswell
Ce.				
C.				
M.	chert	3130		
M.				Pool
K.				Albright
Mz.				
Me.				
V.				
S.				
S.				
A.				
R.				
Pe.				
G.				
TD	3140			

Date Comm. 1-9-57

8" @ 81/80 drlg. 2/45 JAN 23 '57

5'2" @ 3135/100 JAN 20 '57 Co DD
 3142 & 1 1/2 Boph no/w 12
 wa Frac 5x5 & 20 Boph
 no/w Pop FEB 9 '57 ✓ FEB 13 '57 ✓
 FEB 20 '57 ✓ FEB 27 '57 Ph P. 222
 Boph + Trwte gran 39°