


Section 2 Township 34S Range 5E
 Well No. #1 Albright "A"
 Company Harbar Drlg. Co.

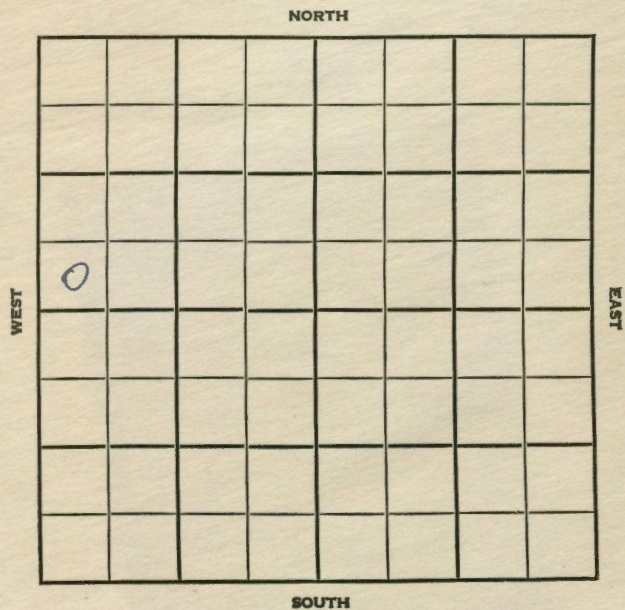

SEC.

TWP.

R.

2

34S

5E

WELL NO.

1 Albright "A"

COMPANY

FARM

Harbar Drlg. Co.

CONTRACTOR

Albright


_____ FT. FROM N. LINE

_____ FT. FROM S. LINE

_____ FT. FROM E. LINE

_____ FT. FROM W. LINE

SW SW NW 300' FWL x
 222' FSL NW/4

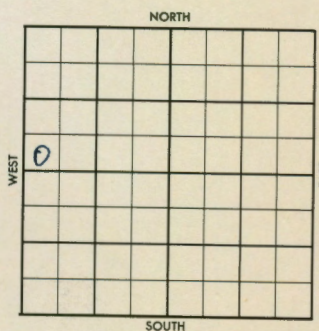

1956

ELEVATION

REPORT

6-20

6-16-56 commenced

8" @ 83

Drlg. 377'

7-18

5 1/2" @ 3126 w/100

DD 3142

B/ 1/4 BOPH / 10% wtr.

Frac 2 x 2

S/ 6 BOPH / 19 BWPH, 2 hrs.

P & F/ 90 BO / 20% wtr. in 21 hrs.

P/ 25 BOPD / 20% wtr.

M. 3111'

TD 3127'

COMPLETED

County Cowley

Elev.

Sec. 2 Twp. 34S Rge. 5ECompany Harbar Drig. Co.FarmName Albright "A" No. 1

TOPS	DEPTH	LOG	DATUM	Loc. in Sec.
Anh.				SW SW NW
TP.				300' fwl x 222
H.				fsl NW/4
Tr.				Geol.
Dg.				Contr.
Bl.				
L.				
K.C.				
B.K.C.				
Ce.				
C.				
M.				
M.				
K.				
Mz.				
Me.				
V.				
S.				
S.				
A.				
R.				
Pe.				
G.				
TD.				

FIRST REPORT

Date Comm. 6/16/56

JUN 20 '56

8" 83, D 377

Sec.

T.

R.

County Cowley

Elev.

Sec. 2 Twp. 34S Rge. 5ECompany Harbar Drig. Co.FarmName Albright "A" No. 1

TOPS	DEPTH	LOG	DATUM	Loc. in Sec.
Anh.				SW SW NW
TP.				300' fwl x 222
H.				fsl NW/4
Tr.				Geol.
Dg.				Contr.
Bl.				
L.				
K.C.				
B.K.C.				
Ce.				
C.				
M.				
M.				
K.				
Mz.				
Me.				
V.				
S.				
S.				
A.				
R.				
Pe.				
G.				
TD.				

COMPLETE

Date Comm. 6/16/56

JUN 27 '56

8" 83, D 377 5 1/2 @ 3126/100

JUL 3 '56 CO DD 3142 TD 1/4

Boph + 10 1/2 wth Frac 2 x 2

6 Boph + 19 BWph 2 hrs

JUL 11 '56 JUL 18 '56 P & F/w 90 Bop +

20% wth in 21 hrs P. 25

Bopd + 20% wth.

Sec.

T.

R.