



Cowley
KANSAS
SECTION 32 TOWNSHIP 34 RANGE 5E
WELL NO. #5 Albright "A"
COMPANY Harbor Oil & Gas

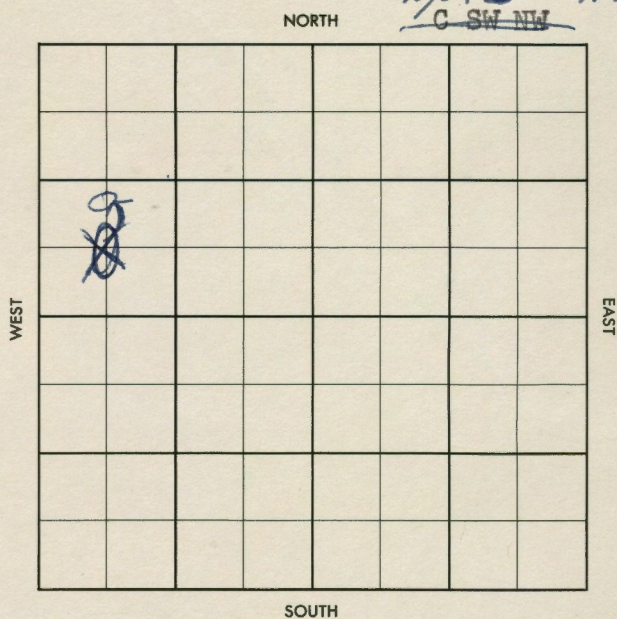

FORM 504-3 SUNRAY

Cowley
KANSAS
SEC. 3 TWP. 34 S R. 5 E
WELL NO. # 5 Albright "A"
COMPANY Harbor Oil & Gas
CONTRACTOR H & M Drlg. Albright

FT. FROM N. LINE
FT. FROM S. LINE
FT. FROM E. LINE
FT. FROM W. LINE

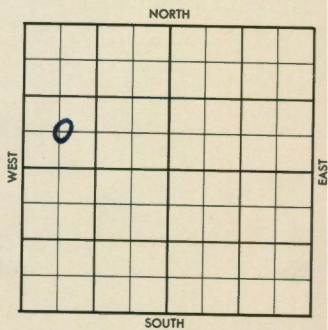

C SW NW

SDX-1/8 Mile

1957 ELEVATION REPORT

6/19 Drlg. 2000'

(FR Tkt)

FORM 504-5 SUNRAY

CORRECTION

[illegible]

Date Comm.

Date Comm.
 drls. 2000 6-10-57
 878 110 1100 5 1/2 3117 175
 MICT CO 3134 B 1/4 Bspth
 10mc JUL 3 '57 FRAC POP JUL 10 '57
 1106 JUL 24 '57
 AUG 8 '57 AUG 28 '57 X 1st
 SEP 4 '57 SEP 11 '57 SEP 18 '57
 Tuck 2nd
 SEP 25 '57 OCT 2 '57
 25 BOPd 35⁰ 2nd

FORM 513 SUNRAY

1205 50 1205

W. M.

County Cowley Elev. _____
Sec. 3 Twp. 34 Rgs. 5E
Company Harbor Oil & Gas
Farm Name Albright "A" No. 5

TOPS	DEPTH	LOG	DATUM	Loc. in Sec.
Anh.				© SW NW
Top.				
H.				
Tr.				
Dg.				
BL.				
L.				Geol. _____
K.C.				
B.K.C.				Contr. _____
Ce.				
C.				H & M Drlg.
M.				
M.				Pool
K.				Albright
Mz.				
Me.				
V.				
S.				
S.				
A.				
R.				
Pf.				
G.				
T.D.				

SDX - 1/8 mile

FIRST REPORT

JUN 19 197

Date Comm.

drlg. 2000

~~29~~