

DX 78-1

Cowley

KANSAS

2


34

5E

Section _____ Township _____ Range _____

Well No. #2 Brown

Company Sun Oil Co.

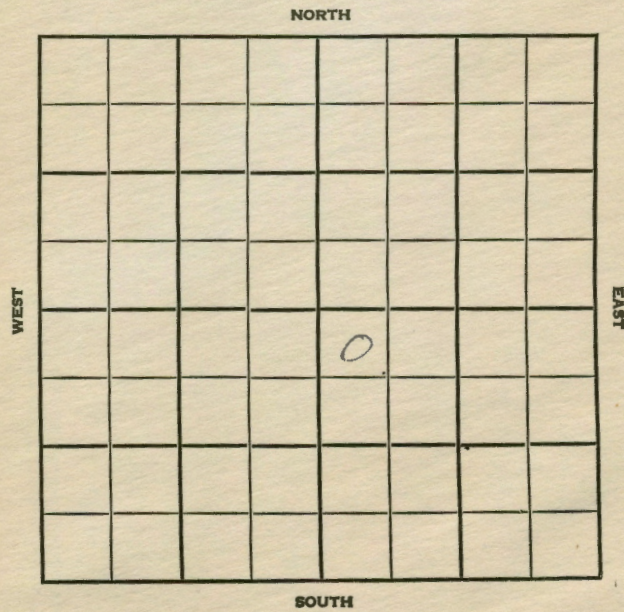

County Cowley Elev. 1265
 Sec. 2 Twp. 34 Rge. 5E
 Company Sun Oil Co.
 Farm Name Brown No. 2

TOPS	DEPTH	LOG	DATUM	Loc. in Sec.
Anh.				NW NW SE
Tr. <u>Laysd</u>	<u>2373</u>			
H.				
Tr.				
Dg.				
Bl.				
L.				Geol.
K.C.	<u>2530</u>			
B.K.C.	<u>2673</u>			Contr. <u>Badger</u>
Ee. <u>Marm</u>	<u>2752</u>			
Ce.	<u>2891</u>			
M. <u>Chert</u>	<u>3138</u>			Pool
M. <u>41</u>	<u>3154</u>			<u>Albright</u>
K.				
Mz.				
Me.				
V.				
S.				
S.				
A.				
R.				
Pe.				
G.				
T.D.	<u>3166</u>			

Date Comm.

Location NOV 27 '56 11-17-56 85/896/100 ID 880 NOV 28 '56 5 1/2 e.DEC 5 '56 5 1/2 3142/125 CO 3166ID 27 Goph 4 hrs 1/4 Frac5x5 8 36 B0 + 3 BW 5 hrsPOP DEC 12 '56 P. 73 Bopd + 2Bwpd Comp. P. 25 Bopd+ 1 Bwpd.

County Cowley Elev. _____
 Sec. 2 Twp. 34 Rge. 5E
 Company Sun Oil Co.
 Farm Name Brown No. 2

TOPS	DEPTH	LOG	DATUM	Loc. in Sec.
Anh.				NW NW SE
Tr.				
H.				
Tr.				
Dg.				
Bl.				
L.				Geol.
K.C.				
B.K.C.				Contr.
Ce.				
C.				
M.				Pool
M.				<u>Albright</u>
K.				
Mz.				
Me.				
V.				
S.				
S.				
A.				
R.				
Pe.				
G.				
T.D.				

Date Comm.

Location

8801 O S VOND.R.