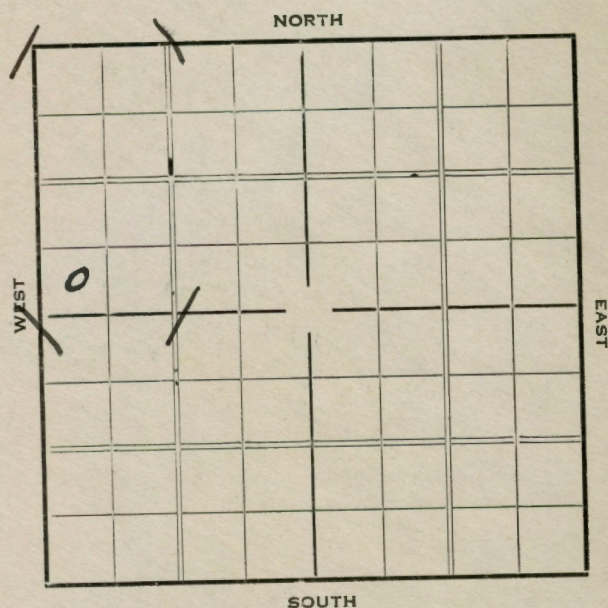


Cowley

KANSAS

Section 2 Township 34 Range 5EWell Number 1 KnappCompany Wakefield & Mead Oil

KANSAS


Cowley

Map No. Sec. 2 Twp. 34 R. 5EWell No. 1 Knapp FarmWakefield & Mead Oil Company

.....Ft. from N. Line

330 Ft. from S. Line

.....Ft. from E. Line

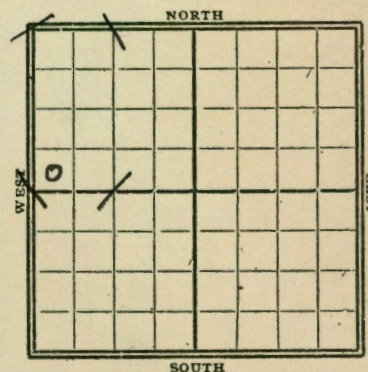330 Ft. from W. LineDate
1936

REPORT

12/9 Location

12/17 Rig

12/24 Rigging up

12/29 Spud.

1937

1/7 15" @ 297'. Drlg. 1265'.

1/14 12" @ 1355'. Drlg. 1380'.

1/21 Drlg. 1620'.

1/28 10" @ 1688'. Drlg. 1725'.

2/4 Drlg. 2125'.

2/11 Dr.g 2460'.

2/18 8" @ 2540'. Drlg. 2944'.

2/26 Chat 3109'. TD 3161' bailed
12 bbls 15 hrs.

3/4 1000 acid. No test.

3/10 Chat 3109'.

T. D. 3217'.


1000 acid.

ABANDONED

KANSAS

County Cowley Map No. 2 Sec. 2 Twp. 34 R. 5EWell No. 1 Napp.Napfield & Mead Oil Company
Contractor

SECTION PLAT

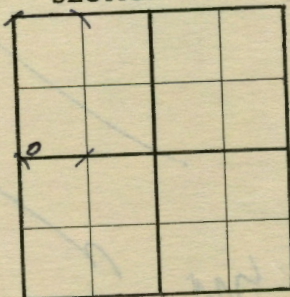

_____ Ft. from N. Line

330 Ft. from S. Line

_____ Ft. from E. Line

330 Ft. from W. Line

FIRST REPORT

Location ✓

Rig up _____

Drilling and Remarks:

RECORD

Cased _____ in., _____ ft.

Sand _____

Gas _____

Oil _____

Total Depth _____

PRODUCTION

1st 24 hrs. Nat. _____

1st 24 hrs. after shot _____

Gas _____ Cu. Ft.

Dry Hole _____

Abandoned _____

Date

DEC 9 1936

19


S. J. LEWIS

Scout

KANSAS

County Cowley Map No. 2 Sec. 2 Twp. 34 R. 5EWell No. 1 Napp.Napfield & Mead Oil Company
Contractor

SECTION PLAT

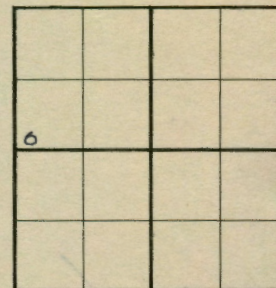

_____ Ft. from N. Line

330 Ft. from S. Line

_____ Ft. from E. Line

330 Ft. from W. Line

ABANDONED

Location _____

Rig up _____

Drilling and Remarks:

Chat 3109
1000 acid

RECORD

Cased _____ in., _____ ft.

Sand _____

Gas _____

Oil _____

Total Depth 3217

PRODUCTION

1st 24 hrs. Nat. _____

1st 24 hrs. after shot _____

Gas _____ Cu. Ft.

Dry Hole ✓Abandoned ✓

Date

MAR 10 1937

19

S. J. LEWIS

Scout