


KANSAS

O. W. D. D.

SECTION 3 TOWNSHIP 34 RANGE 5E

WELL NO. #1 Albright

COMPANY H & M Drlg. Co.

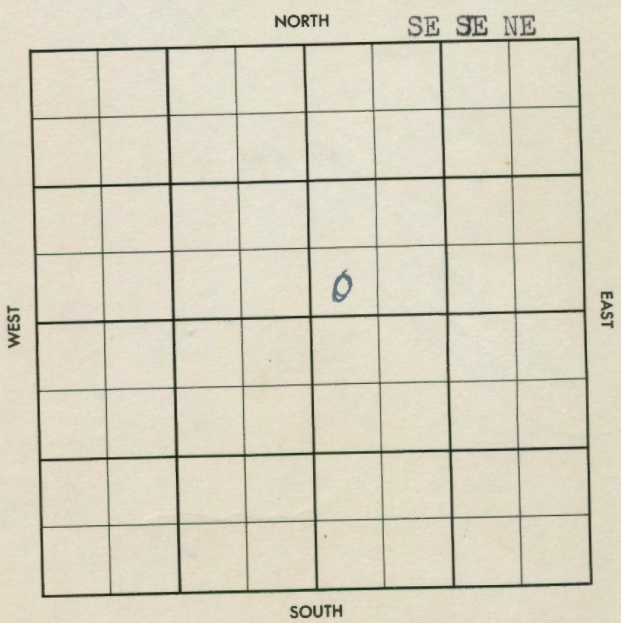

FORM 513 SUNRAY

O. W. D. D

County Cowley Elev. 1229 DF  
 Sec. 3 Twp. 34 Rgn. 5E  
 Company H. & M. Drlg. Co.  
 Farm Name Albright No. 1

TOPS	DEPTH	LOG	DATUM	Loc. in Sec.
Anh.				SE SE NE
TP.				
H.				330' fel x
Tr.				100' fel NE
Dg.				
BL.				
L.	2373			Geol. (OWDD)
K.C.				Contr. O. W. D. D.
B.K.C.				
Ce.				
C.	3111			
M.				
M.				Pool
K.				
Mz.				
Me.				
V.				
S.				
S.				
A				
R.				
PE.				
G.				
T.D.	3136			

NO-RECORD

FIRST REPORT  
 APR 24 57  
 COMPLETE

Date Comm. 5" @ 3126 - was Miss. producer  
 New Info. - RUCT 4-17-57, CO DD 3145 TD  
 Solid cherty limestone, No apparent increase  
 in prod, POP, P/22 bo & 5 bwpd from Miss  
 3126-45 COMPLETE

29