


Section 3 Township 34 Range 5E
 Well No. #2 Albright
 Company Hammer & McClean

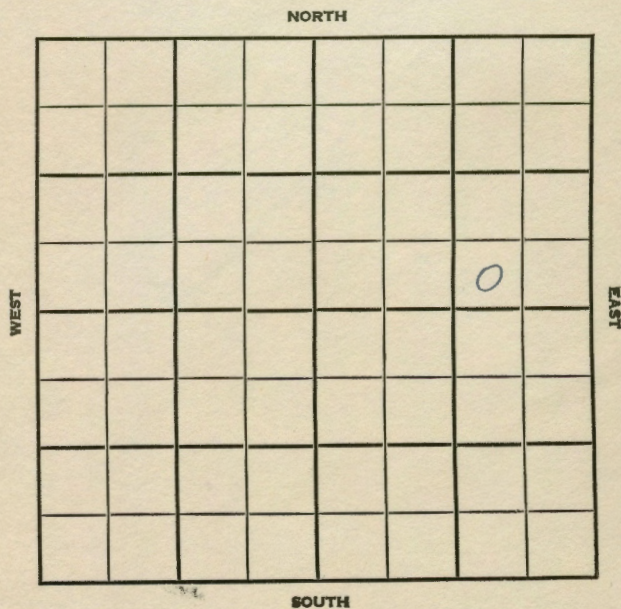

SEC. 3 TWP. 34 R. 5E

WELL NO. #2 Albright FARM

COMPANY Hammer & McClean

CONTRACTOR Co. Tools

Albright


FT. FROM N. LINE

FT. FROM S. LINE

FT. FROM E. LINE

FT. FROM W. LINE

SW SE NE

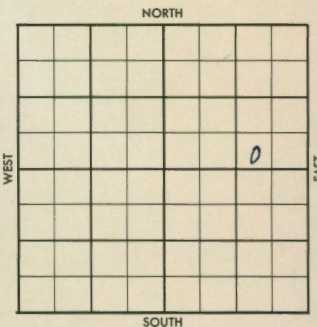

SDX - $\frac{1}{4}$ mile

ELEVATION
 1956 1137' REPORT

7-11 Location
 7-19 "
 7-26 "
 8-2 Spud 7-27-56
 8 5/8" @ 64 w/70
 Drlg. 1730'
 8-9 Layton 2276'; Checkerboard 2554';
 Oswego 2653'; Ce. 2772'; Cong 3026';
 Miss. chat 3033';
 TD 3048'
 5 1/2" @ 3035
 8-16 CO 3048, frac, FU 500' oil, 5 hrs.
 F/ 170 bo
 8-23 P/ 95 bopd
 8-30 NR
 9-5 P 100 BO + 15 BWPD

COMPLETED

1 ~~29~~

County Cowley Elev. _____
 Sec. 3 Twp. 34 Rge. 5E
 Company Hammer & McClean
 FarmName Albright No. 2

TOPS	DEPTH	LOG	DATUM	Loc. in Sec.
Anh.				SW SE NE
Tr.				
Dg.				
Bl.				
L.				Geol.
K.C.				Cantr.
B.K.C.				Co. tools
Ce.				Pool
C.				Albright
M.				
M.				
K.				
Mz.				
Me.				
V.				
S.				
S.				
A.				
R.				
Pe.				
G.				
TD				

Geol. _____
 Cantr. _____
 Co. tools _____
 Pool _____
 Albright _____

FIRST REPORT
 1/4 mile
 JUL 11 '56

Date Comm. _____
 Location _____

8201 JUL 10 1956
 D.R.

County Cowley Elev. 1137
 Sec. 3 Twp. 34 Rge. 5E
 Company Hammer & McClean
 FarmName Albright No. 2

TOPS	DEPTH	LOG	DATUM	Loc. in Sec.
Anh.				SW SE NE
Tr.				
Dg.				
Bl.				
L.				Geol.
K.C.				Cantr.
B.K.C.				Co. tools
Ce.				Pool
C.				Albright
M.				
M.				
K.				
Mz.				
Me.				
V.				
S.				
S.				
A.				
R.				
Pe.				
G.				
TD				

Geol. _____
 Cantr. _____
 Co. tools _____
 Pool _____
 Albright _____

COMPLETE
 1/4 mile
 SEP 5 '56

Date Comm. _____
 Location JUL 18 '56 JUL 25 '56 AUG 1 '56 7-27
-56 85/8 64/70 @ 1730
AUG 8 '56 5 1/2 @ 3035'
AUG 15 '56 CO 3048 TD FRAC.
PAF 925 FU 500' oil 12 hrs.
Flu 170 B0 no/w cs9 & T69.
AUG 22 '56 P. 95 Bopd + wtr. +
Gas AUG 29 '56 SEP 5 '56 P. 100 B0 +
15 Bw pd.