


Section 3 Township 34 Range 5EWell No. #3 AlbrightCompany H & M et al

NORTH

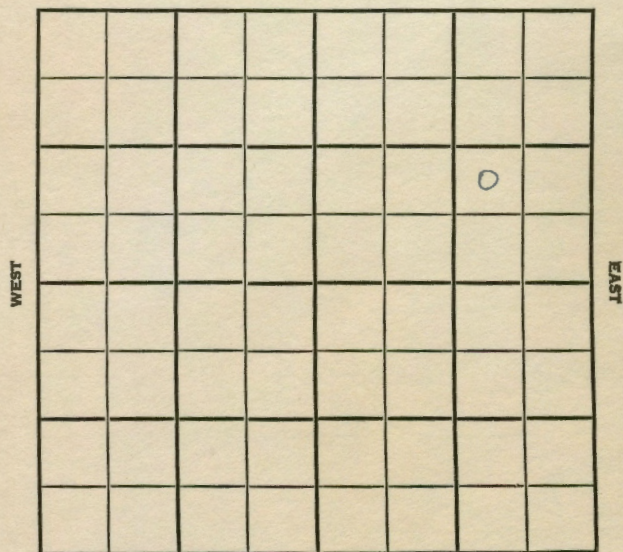

SOUTH

Cowley		KANSAS	
SEC.	TWP.	R.	
3	34	5E	
WELL NO. #3 Albright			
COMPANY H & M et al			
CONTRACTOR			
Albright			
_____ FT. FROM N. LINE			
_____ FT. FROM S. LINE			
_____ FT. FROM E. LINE			
_____ FT. FROM W. LINE			
NW SE NE			

NORTH									
SOUTH									

ELEVATION		REPORT	
1956			
8-15	MIR		

FORM 513 SUNRAY

County Cowley Elev. 11.97
 Sec. 3 Twp. 34 Rge. 5E
 Company H & M etal.
 FarmName Albright No. 3

TOPS	DEPTH	LOG	DATUM	Loc. in Sec.
Anh. <u>5701</u>	<u>1839</u>			NW SE NE
TP.				
H. <u>Layton</u>	<u>2256</u>			
Tr. <u>sd</u>	<u>2294</u>			
Dg. <u>chkd</u>	<u>2552</u>			
Bl. <u>osw</u>	<u>2650</u>			
L.				
K.C.				Geol.
B.K.C.				Contr.
Ce.	<u>2785</u>			
C.				
M. <u>-cg</u>	<u>3025</u>			
M. <u>chat</u>	<u>3031</u>			Pool
M. <u>M.L.</u>	<u>3040</u>			Albright
M.				
Me.				
V.				
S.				
S.				
A.				
R.				
Pe.				
G.				
T.D.	<u>3058</u>			

Date Comm.

MIR AUG 22 '56 8-17-56 85/8
 80/70 # 2300 AUG 29 '56 SEP 5
 7" C 2425/100 To be SWD
 SEP 12 '56 C 2400 120/2340-
 PB 1950 SEP 26 '56 PF 1877-190
 Sgd. OCT 3 '56 # 2500 4100
 OCT 10 '56 WOCT OCT 17 '56 OCT 24 '56
 NOV 7 '56 NOV 13 '56 ✓ Put
 water into Layton camp SWD

FORM 513 SUNRAY

County Cowley Elev. 34
 Sec. 3 Twp. 34 Rge. 5E
 Company H & M etal.
 FarmName Albright No. 3

TOPS	DEPTH	LOG	DATUM	Loc. in Sec.
Anh.				NW SE NE
TP.				
H.				
Tr.				
Dg.				
Bl.				
L.				Geol.
K.C.				Contr.
B.K.C.				
Ce.				
C.				
M.				
M.				Pool
K.				Albright
Mz.				
Me.				
V.				
S.				
S.				
A.				
R.				
Pe.				
G.				
T.D.				

Date Comm.

MIR

AUG 15 '56

FIRST REPORT

29

D.R.