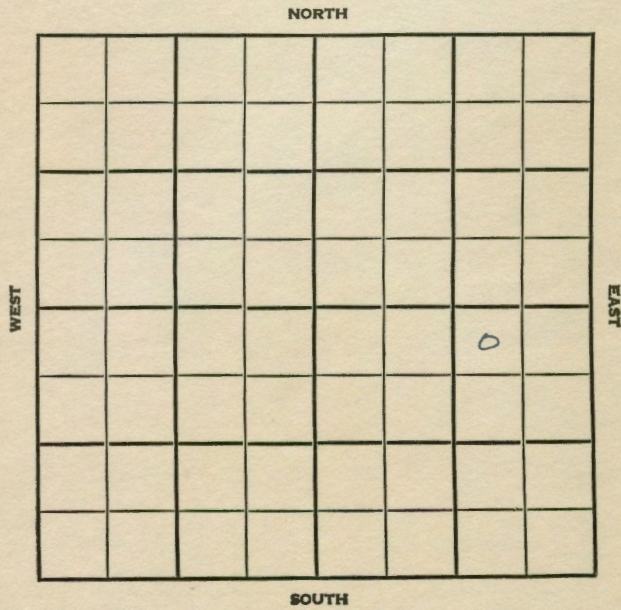


Section 3 Township 34 Range 5EWell No. #2 BrownCompany Hammer & Maclean & C.R.A.SEC. 3 TWP. 34 R. 5E

WELL NO.

#2 Brown

COMPANY

Hammer & Maclean & CRA

CONTRACTOR

Albright


FT. FROM N. LINE

FT. FROM S. LINE

FT. FROM E. LINE

FT. FROM W. LINE

NW NE SE

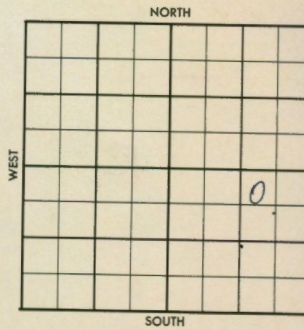

1956

ELEVATION

REPORT

8-29

Location

FORM 513 SUNRAY

County Cowley Elev. 1207
 Sec. 3 Twp. 34 Rge. 5E
 Company Hammer & Maclean & C.R.A.
 Farm Name Brown No. 2

TOPS	DEPTH	LOG	DATUM	Loc. in Sec.
Anh.				
TP.				
H.	<u>2241</u>	<u>650</u>		
Tr.	<u>2629</u>			
Dg.	<u>2736</u>			
Bl.				
L.				
K.C.				
B.K.C.				
Ce.	<u>2859</u>			
C.				
M.	<u>3096</u>			
M.	<u>3104</u>			
K.				
Mz.				
Me.				
V.				
S.				
S.				
A.				
R.				
Pe.				
G.				
T.D.	<u>3120</u>			

COMPLETE

Date Comm. OCT 10 1956
 Location SEP 5 '56 MIR SEP 12 '56 9-7
-56 85/8 82/85 D 2080 SEP 14
5 1/2 @ 3108/50 SEP 26 '56 CO 3120
Frac \$ 6 1/2 Boph OCT 3 '56
OCT 10 '56 P. 125 Bopd 1590 wt
P. 55 Bop + 15 BW in 24 hr

FORM 513 SUNRAY

County Cowley Elev. 1207
 Sec. 3 Twp. 34 Rge. 5E
 Company Hammer & Maclean & C.R.A.
 Farm Name Brown No. 2

TOPS	DEPTH	LOG	DATUM	Loc. in Sec.
Anh.				
TP.				
H.				
Tr.				
Dg.				
Bl.				
L.				
K.C.				
B.K.C.				
Ce.				
C.				
M.				
M.				
K.				
Mz.				
Me.				
V.				
S.				
S.				
A.				
R.				
Pe.				
G.				
T.D.				

Pool
Albright

FIRST REPORT

AUG 29 '56

Date Comm.

Location