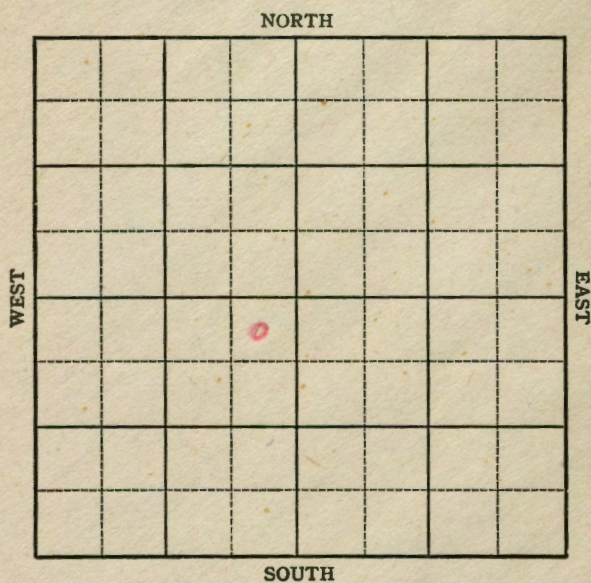


KANSAS

Cowley county

Section 9 Township 34 Range 5-EWell No. #1 LongCompany Dillworth Hager

KANSAS

Cowley C

Sec. 9 Twp. 34 R. 5-EWell No. #1 Long FarmDillworth Hager Company


Miscellaneous

330 Ft. from N. Line

Ft. from S. Line

330 Ft. from E. Line

Ft. from W. Line

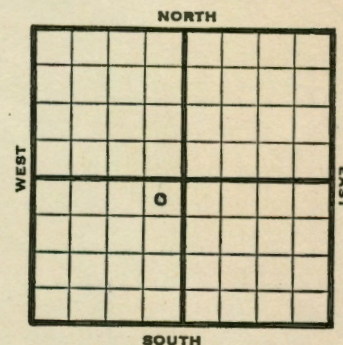

NE SW

## REPORT

1947 Elev. 1205'

1/29 Location

2/5 8" @ 160  
Drlg 550'

2/12 Drlg 2966'

2/19 Miss 3159'  
TD 3179'
$$\begin{array}{r} 3159 \\ 1205 \\ \hline 1954 \end{array}$$

ABANDONED

Kansas

KANSAS

34

5E

Map No.

2

Sec.

9

Twp.

R.

Well No.

1 Long

Dillworth Hager

Company

ABANDONED

Contractor

NE SW

SECTION PLAT

330

Ft. from N. Line

Ft. from S. Line

330

Ft. from E. Line

Ft. from W. Line

Cowley County

Location

Rig up

Drilling and Remarks:

None 8155

## RECORD

Cased in. ft.

Sand

Gas

Oil

Total Depth 3179

## PRODUCTION

1st 24 hrs. Nat.

1st 24 hrs. after shot

Gas Cu. Ft.

Dry Hole

Abandoned

Date

FEB 19 1947 19

S. J. LEWIS

Scout

Kansas

KANSAS

Map No.

2

Sec.

9

Twp.

34

R.

5E

Well No. 1 Long

Dillworth Hager

Company

FIRST REPORT

Contractor

NE SW

SECTION PLAT

330

Ft. from N. Line

Ft. from S. Line

330

Ft. from E. Line

Ft. from W. Line

Cowley County

Location X

Rig up

Drilling and Remarks:

## RECORD

Cased in. ft.

Sand

Gas

Oil

Total Depth

## PRODUCTION

1st 24 hrs. Nat.

1st 24 hrs. after shot

Gas Cu. Ft.

Dry Hole

Abandoned

Date

JAN 29 1947 19

S. J. LEWIS

Scout