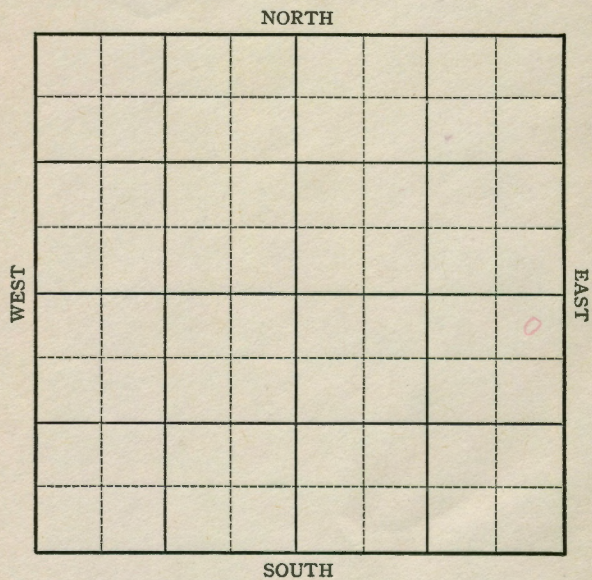



KANSAS
CowleySection 12 Township 34 Range 5EWell No. #5 WaldschmidtCompany Blair & M Mahon

KANSAS

Cowley

Sec. 12 Twp. 34 R. 5EWell No. #5 Waldschmidt FarmBlair & M Mahon Company

Miscellaneous

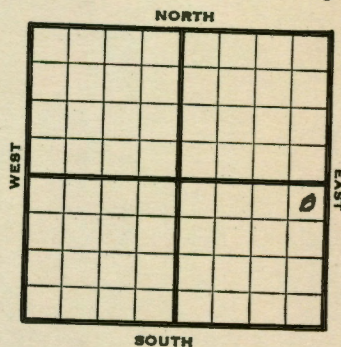330 Ft. from N. Line Ft. from S. Line330 Ft. from E. Line Ft. from W. Line

NE SE

1944

REPORT

8/23

8/30

Rotary

10" @ 45'

Drlg. 1435

9/8

9-13

Drlg. 2885'

Miss 3031

TD 3036

ABANDONED

Pool Name MiscellaneousMap No. 2 Sec. 12 Twp. 34 R. 5EWell No. 5 WaldschmidtBlair & McMahon CompanyABANDONED Contractor

NE SE

SECTION PLAT

330 Ft. from N. Line

Ft. from S. Line

330 Ft. from E. Line

Ft. from W. Line

Cowley County

Location

Rig up

Drilling and Remarks:

Misc 3031

RECORD

Cased in, ft.

Sand

Gas

Oil

Total Depth 3036

PRODUCTION

1st 24 hrs. Nat.

1st 24 hrs. after shot

Gas Cu. Ft.

Dry Hole

Abandoned

Date

SEP 13 1944 19 S. J. LEWIS ScoutPool Name MiscellaneousMap No. KANSAS Sec. 12 Twp. 34 R. 5EWell No. 5 WaldschmidtBlair & M. Mahon CompanyFIRST REPORT Contractor

NE SE

SECTION PLAT

330 Ft. from N. Line

Ft. from S. Line

330 Ft. from E. Line

Ft. from W. Line

Cowley County

Location

Rig up

Drilling and Remarks:

Rotary

RECORD

Cased in, ft.

Sand

Gas

Oil

Total Depth 3036

PRODUCTION

1st 24 hrs. Nat.

1st 24 hrs. after shot

Gas Cu. Ft.

Dry Hole

Abandoned

Date

AUG 23 1944 19 S. J. LEWIS Scout