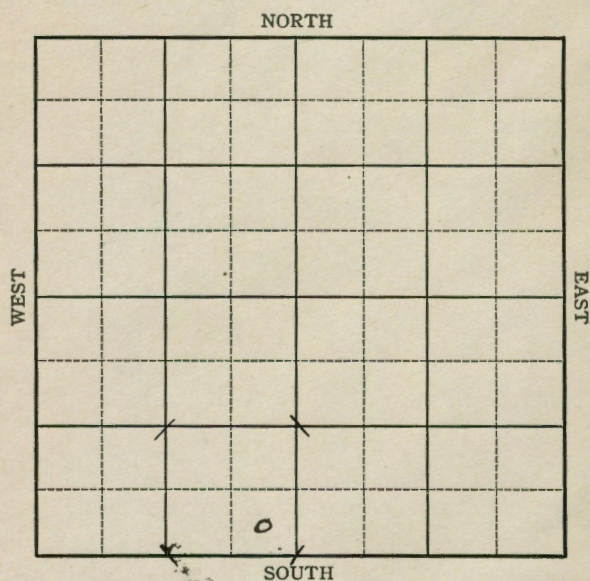


KANSAS

FORM 51 5M 1-42 PETROL

Cowley


Section 12 Township 34 Range 5-EWell No. #1 E. WaldschmidtCompany B. B. BlairFORM 252-A
5M 9-42 GAS

KANSAS

Cowley

Sec. 12 Twp. 34 R. 5-EWell No. #1 E. Waldschmidt FarmB. B. Blair Company

Miscellaneous

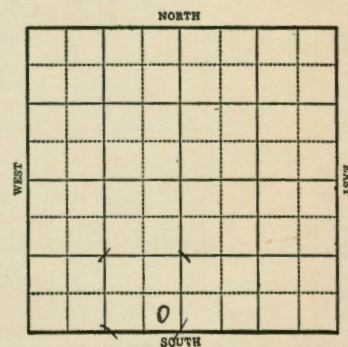 Ft. from N. Line330 Ft. from S. Line330 Ft. from E. Line Ft. from W. LineElev. 1118

REPORT

1943

6/23	Rotary
6/30	"
7/7	10" @ 87'
	T.D. 850' SD
7/15	" " "
7/21	// " "
7/28	5" @ 2913
	T.D. 9262
	20 qts 2922-32 CO
8/4	1500' oil
8/11	SD
8/18	"
8/25	Flow 28 oil in 24 hrs.
9/1	Batt. 2922 " "
9/8	5" @ 2913 " "
	T.D. 2962'
9/15	20 qts. 2922-32
	Pump 25 Pot.
	Gravity 39.8

COMPLETED

KANSAS

Map No. 2 Sec. 12 Twp. 34 R. 5EWell No. 1 E. WalldschmidtB. B. Blair CompanyCOMPLETED Contractor


SE SW

SECTION PLAT

Ft. from N. Line

330 Ft. from S. Line330 Ft. from E. Line

Ft. from W. Line

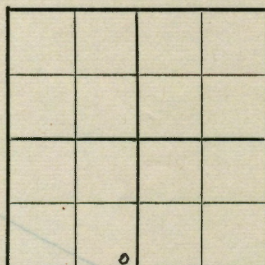

Miscellaneous

Location

Rig up

Drilling and Remarks:

*Bar Y 2922**5-10-29-13**209 to 2922-32**Pump 25 Pk**29 E G*

RECORD

Cased in, ft.

Sand

Gas

Oil

Total Depth 2962

PRODUCTION

1st 24 hrs. Nat.

1st 24 hrs. after shot

Gas Cu. Ft.

Dry Hole

Abandoned

Date

SEP 1 1943 19

S. J. LEWIS Scout

Cowley

KANSAS

Map No. 2 Sec. 12 Twp. 34 R. 5EWell No. 1 E. WalldschmidtB. B. Blair CompanyFIRST REPORT Contractor


SE SW

SECTION PLAT

Ft. from N. Line

330 Ft. from S. Line330 Ft. from E. Line

Ft. from W. Line

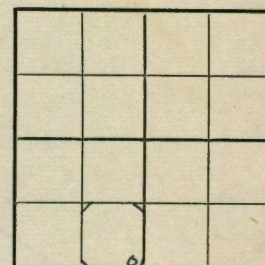

MISCELLANEOUS

Location

Rig up

Drilling and Remarks:

Rotary

RECORD

Cased in, ft.

Sand

Gas

Oil

Total Depth

PRODUCTION

1st 24 hrs. Nat.

1st 24 hrs. after shot

Gas Cu. Ft.

Dry Hole

Abandoned

Date

JUN 23 1943 19

S. J. LEWIS Scout