

KANSAS
FORM 51 5M BRIX

H Cowley


Section 12 Township 34 Range 5E

Well No. #4 M Waldschmidt

Company Blair et al

Miscellaneous

NORTH

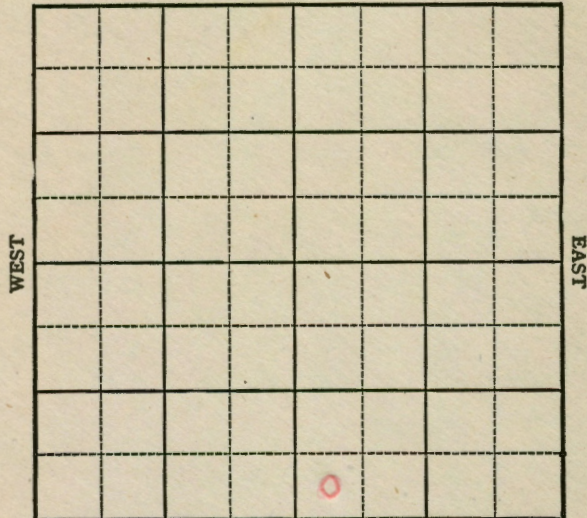

SOUTH

FORM 252-A
5M 3-44 PETROL

KANSAS

Cowley

Sec. 12 Twp. 34 R. 5E

Well No. #4 M Waldschmidt Farm

Blair et al Company

Miscellaneous


 Ft. from N. Line

330 Ft. from S. Line

 Ft. from E. Line

330 Ft. from W. Line

Elev. 1133

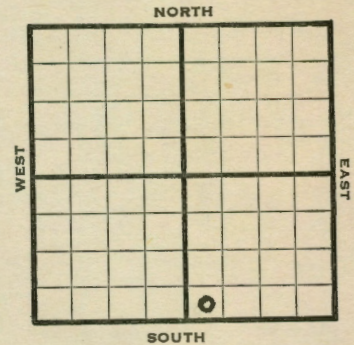

1944

REPORT

7/26 Derrick
8/2 10" @ 84 WOC
8/9 Drlg. 1890
8/16 Miss. 2989
TD 2994
8/23 Miss 2989
TD 2994

ABANDONED

Pool Name MiscellaneousMap No. 2 Sec. 12 Twp. 34 R. 5EWell No. 4 M. WaldschmidtBlair etal. CompanyABANDONED Contractor

SW SE

SECTION PLAT

Ft. from N. Line

330 Ft. from S. Line

Ft. from E. Line

330 Ft. from W. LineCowley County

Location

Rig up

Drilling and Remarks:

Miss 2989

RECORD

Cased in. ft.

Sand

Gas

Oil

Total Depth 2994

PRODUCTION

1st 24 hrs. Nat.

1st 24 hrs. after shot

Gas Cu. Ft.

Dry Hole

Abandoned

Date

AUG 23 1944

19

S. J. LEWIS

Scout

Pool Name MiscellaneousMap No. 2 Sec. 12 Twp. 34 R. 5EWell No. 4 M. WaldschmidtBlair etal. CompanyFIRST REPORT Contractor

SW SE

SECTION PLAT

Ft. from N. Line

330 Ft. from S. Line

Ft. from E. Line

330 Ft. from W. LineCowley County

Location

Rig up

Drilling and Remarks:

Derrick

RECORD

Cased in. ft.

Sand

Gas

Oil

Total Depth

PRODUCTION

1st 24 hrs. Nat.

1st 24 hrs. after shot

Gas Cu. Ft.

Dry Hole

Abandoned

Date

JUL 26 1944

19

S. J. LEWIS

Scout