


Section 10 Township 34 Range 5E
 Well No. #1 J. Rehn (Rahn)
 Company Hammer & McClean

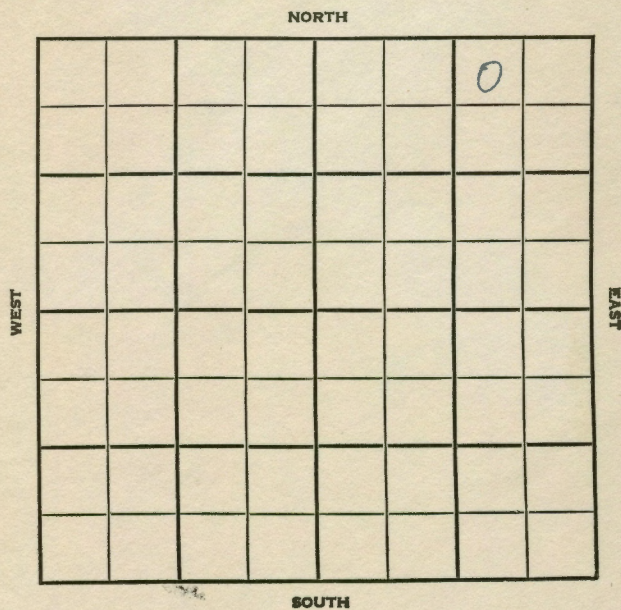

SEC.

10

TWP.

34

R.

5E

WELL NO.

#1 J. Rehn

FARM

COMPANY

Hammer & McClean

CONTRACTOR

Co. Tools

Albright


FT. FROM N. LINE

FT. FROM S. LINE

FT. FROM E. LINE

FT. FROM W. LINE

NW NE NE

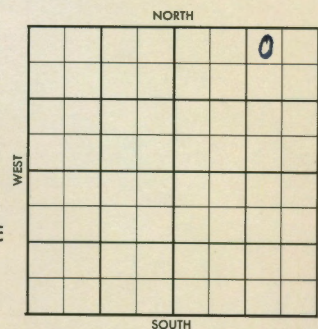

1956

ELEVATION

1169'

REPORT

7-11 ~~#####~~ Location

7-19 MIR

7-26 Spud 7-16-56
 8 5/8" @ 79
 Layton 2292,; Checkerboard 1m 2585';
 Cored 2291-2329, rec. 38';
 Drlg. 2845'

8-2 Miss chat 3067';

TD 3079'

5 1/2" @ 3068

8-9

CO

DD 3093

FU 5 go, 15 gw 12 hrs, 250 A

Frac,

S/ 3 boph

8-13 POP

8-23 No report

8-30 P/5 BO 25 BW 24 hr

9-5 P 5 BO + 25 BW 24 hrs (Comp)

COMPLETED

FORM 513 SUNRAY

County Cowley Elev. 1167
 Sec. 10 Twp. 34 Rgs. 5D
 Company Hammer & McClean
 Farm Name J. Rehn No. 1

	DEPTH	LOG	DATUM	Loc. in Sec.
2292				
CHK 6d 2585				
BL.				Geol.
L.				Contr.
K.C.				Co. tools
B.K.C.				
Ce.				
C.				
M. chat 3067				Pool
M.				Albright
K.				
Mz.				
Mo.				
V.				
S.				
S.				
A.				
R.				
Pe.				
G.				
TD.	3079			

Date Comm.

Location JUL 18 '56 MIR JUL 31 '56 7-1
 -56 85/8 29 crd 2291-
 2329 sec 38' ID 2845 AUG 1
 5/2 @ 3068/ AUG 8 '56 CO RD
 3089 TD FU 560 + 156W
 12 hrs 1/4 Frac 3x3 X
 3M. Pump + Tr. wh (Load oil)
 AUG 15 '56 POP AUG 22 '56 AUG 29 '56 P
 B0 + 25 BW 24 hrs (con)
 M. 600 5000 10000

FORM 513 SUNRAY

County Cowley Elev. 1167
 Sec. 10 Twp. 34 Rgs. 5E
 Company Hammer & McClean
 Farm Name J. Rehn No. 1

TOPS	DEPTH	LOG	DATUM	Loc. in Sec.
Anh.				NW NE NE
T.P.				
H.				
Tr.				
Dg.				
BL.				
L.				Geol.
K.C.				Contr.
B.K.C.				Co. tools
Ce.				
C.				
M.				Pool
M.				Albright
K.				
Mz.				
Mo.				
V.				
S.				
A.				
R.				
Pe.				
G.				
TD.				

Date Comm.

Location

JUL 1 1956

JUL 1 1956