


KANSAS

Cowley

Form 51-5M-7-39-Palace

Section 12 Township 34 Range 5-EWell No. #1 ScottCompany Tulsa Oil

NORTH Wildcat

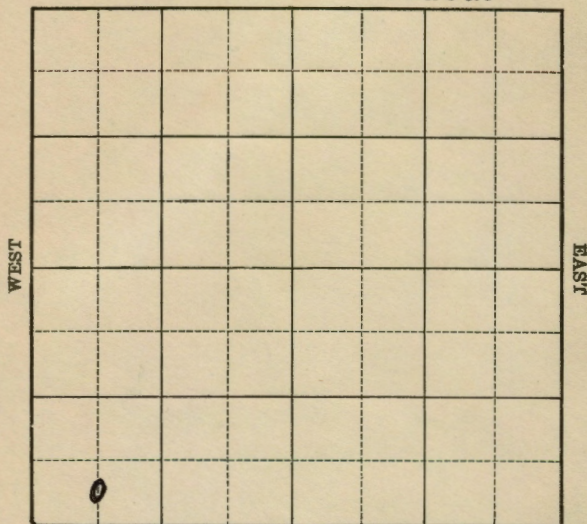

SOUTH

FORM 252-A 5M

Cowley


Sec. 12 Twp. 34 R. 5-EWell No. #1 Scott FarmTulsa Oil Company

(Wildcat)

Ft. from N. Line

330 Ft. from S. Line

Ft. from E. Line

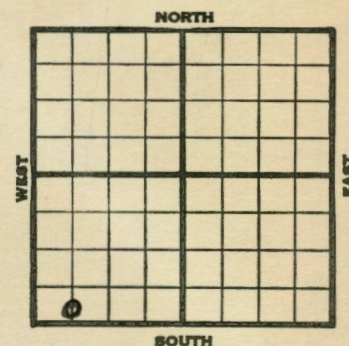660 Ft. from W. Line

1939

REPORT

12/27 Drlg. 1900'

1940

1/4 Bart. 2920' 7" - 2918'

T.D. 2924' WOC.

1/11 " " "

1/18 " " "

1/25 " " "

2/1 Shut down.

2/7 Miss. 2979'

T.D. 3001'

No shows.

ABANDONED

Map No. 2 Sec. 12 Twp. 34 R. 5EWell No. 1 ScottTulsa Oil

Company

Contractor

ABANDONED

SE SW SW

Ft. from N. Line

330 Ft. from S. Line

Ft. from E. Line

660 Ft. from W. Line

WILDCAT

Location

Rig up

Drilling and Remarks:

*Miss 2979**No shows*

RECORD

Cased in., ft.

Sand

Gas

Oil

Total Depth 3001

PRODUCTION

1st 24 hrs. Nat.

1st 24 hrs. after shot

Gas Cu. Ft.

Dry Hole

Abandoned

Date

FEB 7 1940 19*S. J. LEWIS* ScoutMap No. 2 Sec. 12 Twp. 34 R. 5EWell No. 1 ScottTulsa, Oil

Company

Contractor

FIRST REPORT

SECTION PLAT

~~SE SW SW~~

Ft. from N. Line

330 Ft. from S. Line

Ft. from E. Line

660 Ft. from W. Line

WILDCAT

Location

Rig up

Drilling and Remarks:

Drlg. 1900'

RECORD

Cased in., ft.

Sand

Gas

Oil

Total Depth

PRODUCTION

1st 24 hrs. Nat.

1st 24 hrs. after shot

Gas Cu. Ft.

Dry Hole

Abandoned

Date

DEC 27 1939

19

S. J. LEWIS Scout