



Section 12 Township 34 Range 5-E
 Well No. #1 Waldschmidt
 Company B. E. Blair

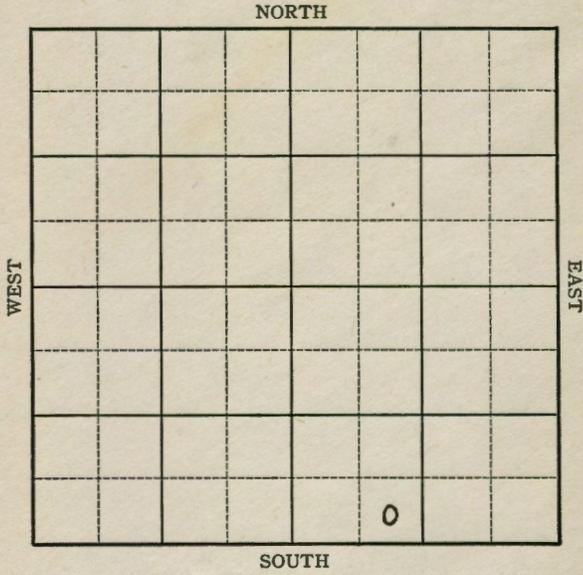

Sec. 12 Twp. 34 R. 5-E
 Well No. #1 Waldschmidt Farm
B. E. Blair Company

_____ Ft. from N. Line
330 Ft. from S. Line
 _____ Ft. from E. Line
990 Ft. from W. Line

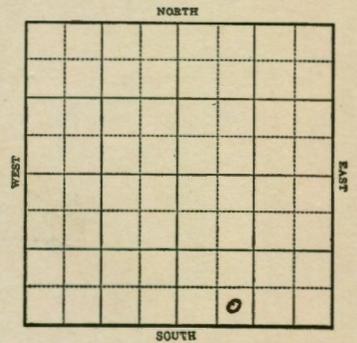

1943 Elev. 1131 REPORT

| | |
|-------|--------------------------|
| 7/21 | Rotary |
| 7/28 | 10" @ 69' |
| | Drlg. 1600' |
| 8/4 | Bart. 2920 |
| | 5" @ 2916' |
| | T.D. 2922' |
| | RUST |
| 8/11 | T.D. 2934' |
| | HFO 3 hrs. |
| 8/18 | T.D. 2959' |
| | Flow 100' oil in 12 hrs. |
| 8/25 | " " " |
| 9/8 | " " " |
| 9/15 | " " " |
| 9/22 | " " " |
| 9/29 | " " " |
| 10/6 | " " " |
| 10/13 | " " " |
| 10/20 | " " " |
| 10/27 | " " " |

OVER

1943
11/3

Bart 2920
5" @ 2916'
Pump 400 Pot.
T.D. 2959
Gravity 38.4

COMPLETED

KANSAS

Map No. 2 Sec. 12 Twp. 34 R. 5E

Well No. 1 J. Waldschmidt

B. B. Blair Company

COMPLETED Contractor

SE SW SE


SECTION PLAT

Ft. from N. Line

330 Ft. from S. Line

Ft. from E. Line

990 Ft. from W. Line

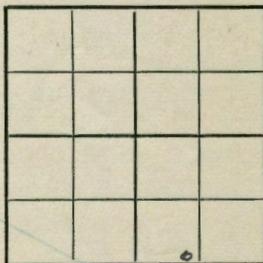

Miscellaneous

Location

Rig up

Drilling and Remarks:

Bar 2920
5" 2916
Pump 400 Pst
38 3/4

RECORD

Cased in, ft.

Sand

Gas

Oil

Total Depth 2959

PRODUCTION

1st 24 hrs. Nat.

1st 24 hrs. after shot

Gas Cu. Ft.

Dry Hole

Abandoned

Date

NOV 3 1943 19

S. J. LEWIS Scout

KANSAS

Map No. 2 Sec. 12 Twp. 34 R. 5E

Well No. 1 Waldschmidt

B. B. Blair Company

FIRST REPORT Contractor

SE SW SE


SECTION PLAT

Ft. from N. Line

330 Ft. from S. Line

Ft. from E. Line

990 Ft. from W. Line

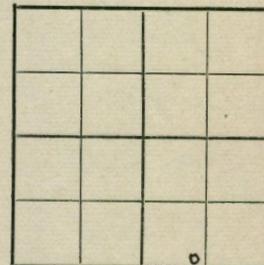

MISCELLANEOUS

Location

Rig up

Drilling and Remarks:

Rotary

RECORD

Cased in, ft.

Sand

Gas

Oil

Total Depth

PRODUCTION

1st 24 hrs. Nat.

1st 24 hrs. after shot

Gas Cu. Ft.

Dry Hole

Abandoned

Date

JUL 21 1943 19

S. J. LEWIS Scout