

KANSAS

Cowley County

Sec. 13 Twp. 34 R. 5EWell No. #6 Rahn Farm _____

Jack Garden

Company _____

Miscellaneous

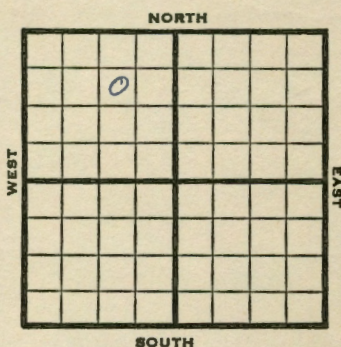
990 Ft. from N. Line

_____ Ft. from S. Line

990 Ft. from E. Line

_____ Ft. from W. Line

SW NE NW

1946 **Elev. 1108** REPORT

5/22 Rotary

5/29 10" @ 45' WOC

6/5 1728' S.D.

6/12 **Bart 2919'**

TD 2922-5" @ 2920', RUST

6/18 " " "

6/26 TD 2952'

80 qts 2928-48 CO

7/3 Pump 175 oil in 24 hrs.

7/9 " " "

7/16 " " "

7/23 " " "

7/31 **Bart. 2919**

5" @ 2920

80 qts. 2928-2948

TD 2952

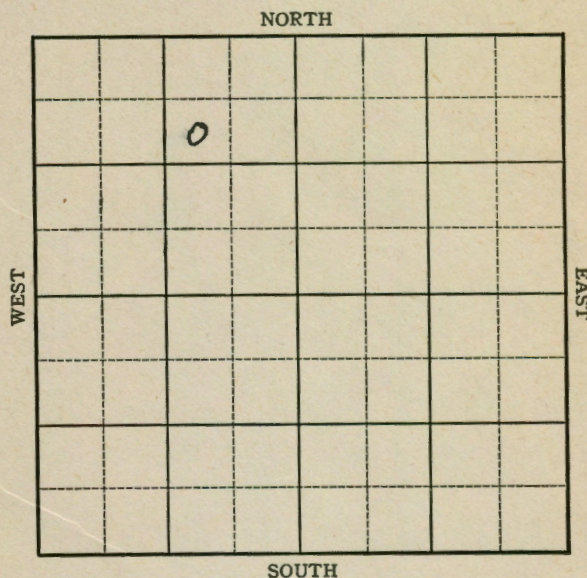
Pump 148 Pot.

Grav. 40.0

COMPLETED

KANSAS

Cowley

Section 13 Township 34 Range 5EWell No. 6 RahnCompany Jack Garden

KANSAS Pool Name Miscellaneous
 Map No. 2 Sec. 13 Twp. 34 R. 5E
 Well No. 6 Rahn

Jack Garden Company

FIRST REPORT Contractor

SW NE NW

SECTION PLAT

990 Ft. from N. Line
 _____ Ft. from S. Line
990 Ft. from E. Line
 _____ Ft. from W. Line

Cowley County

Location _____

Rig up _____

Drilling and Remarks:

Rotary

RECORD

Cased _____ in., _____ ft.

Sand _____

Gas _____

Oil _____

Total Depth _____

PRODUCTION

1st 24 hrs. Nat. _____

1st 24 hrs. after shot _____

Gas _____ Cu. Ft.

Dry Hole _____

Abandoned _____

Date

MAY 22 1946

19

S. J. LEWIS

Scout

KANSAS Pool Name Miscellaneous
 Map No. 2 Sec. 13 Twp. 34 R. 5E
 Well No. 6 Rahn

Jock Garden Company

Company

COMPLETED

Contractor

SW NE NW

E11108
 SECTION PLAT

990 Ft. from N. Line

_____ Ft. from S. Line

990 Ft. from E. Line

_____ Ft. from W. Line

Cowley County

Location _____

Rig up _____

Drilling and Remarks:

Barx 2915

5" @ 2920

SD to 2925-48

Run 148 BX

40° S

RECORD

Cased _____ in., _____ ft.

Sand _____

Gas _____

Oil _____

Total Depth 2952

PRODUCTION

1st 24 hrs. Nat. _____

1st 24 hrs. after shot _____

Gas _____ Cu. Ft.

Dry Hole _____

Abandoned _____

Date

JUL 31 1946

19

S. J. LEWIS

Scout