

FORM 51 5M 10-41 PETROL

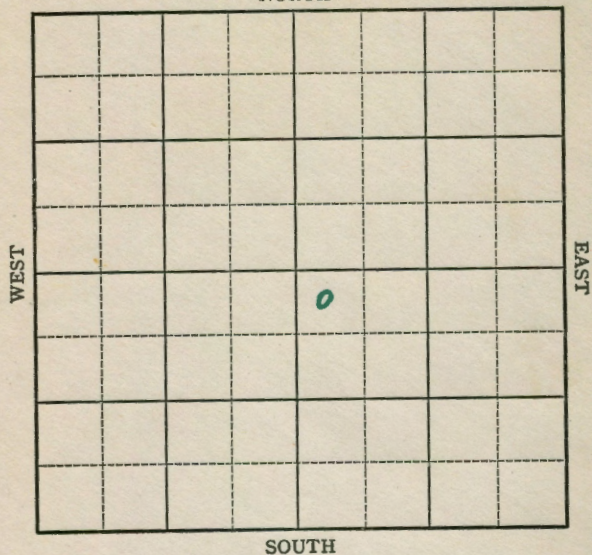
Cowley

Section 13 Township 34 Range 5-E

Well No. 1 Oxford

Company Rocket Drilling et al

NORTH Rahn Pool



FORM 252-A
5M 10-41 PETROL

KANSAS

Cowley

Sec. 13 Twp. 34 R. 5-E

Well No. #1 Oxford Farm

Rockett Drilling et al _____ Company

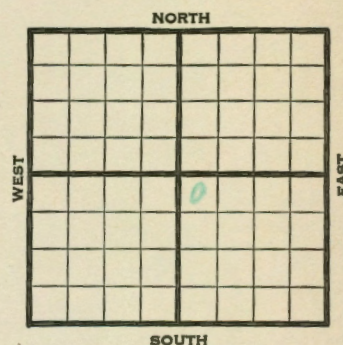
(Rahn)

330 Ft. from N. Line

_____ Ft. from S. Line

Ft. from E. Line

330 Ft. from W. Line

[illegible]

KANSAS

Map No. 2 Sec. 13 Twp. 34 R. 5EWell No. 1 Oxford

Rocket Drilling et al. Company

ABANDONED

Contractor

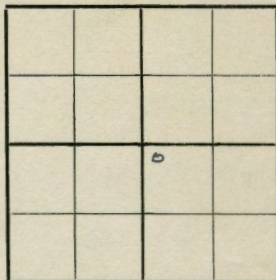
NW SE

SECTION PLAT

330 Ft. from N. Line

Ft. from S. Line

Ft. from E. Line

330 Ft. from W. Line

RAHN POOL

Location

Rig up

Drilling and Remarks:

*Miss 2990**Noshows*

RECORD

Cased in. ft.

Sand

Gas

Oil

Total Depth 2994

PRODUCTION

1st 24 hrs. Nat.

1st 24 hrs. after shot

Gas Cu. Ft.

Dry Hole

Abandoned

Date

APR 1 1942 19

S. J. LEWIS Scout

KANSAS

Map No. 2 Sec. 13 Twp. 34 R. 5EWell No. 1 Oxford

Rocket Drilling et al. Company

FIRST REPORT

Contractor

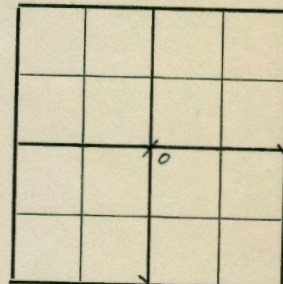
NW SE

SECTION PLAT

330 Ft. from N. Line

Ft. from S. Line

Ft. from E. Line

330 Ft. from W. Line

RAHN POOL

Location

Rig up

Drilling and Remarks:

Derrick

RECORD

Cased in. ft.

Sand

Gas

Oil

Total Depth

PRODUCTION

1st 24 hrs. Nat.

1st 24 hrs. after shot

Gas Cu. Ft.

Dry Hole

Abandoned

Date

MAR 11 1942 19

S. J. LEWIS Scout