


KANSAS

FORM 51 5M PETROL

Cowley

Section 14 Township 34 Range 5-EWell No. #1 O. T. CollierCompany Ben Gralapp etal

NORTH

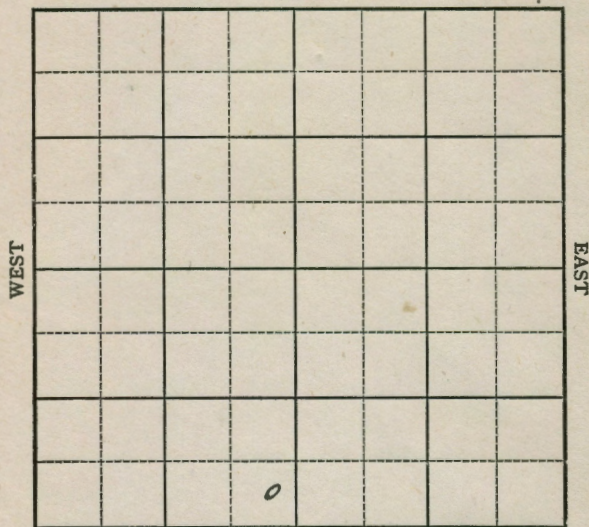

SOUTH

FORM 252-A
5M 9-43 GASS

Cowley


Sec. 14 Twp. 34 R. 5-EWell No. #1 O. T. Collier FarmBen Gralapp etal Company

NORTH

Ft. from N. Line

330 Ft. from S. Line250 Ft. from E. Line

Ft. from W. Line

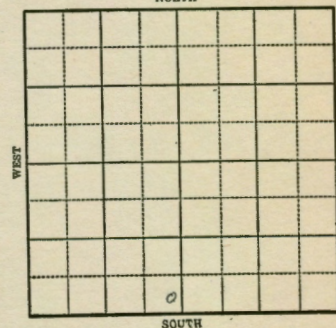

SOUTH

1943

REPORT

12-22 Rotary

12/29 8" @ 112
Drlg 1490'

1944

1-5 **Bart 3007**

TD 3022

Run csg.

1-12 6" @ 3006

Drlg 3019 CO

1/19 Flow 150 oil in 24 hrs. 2 M. Gas.

1/26 " " " "

2/2 " "

2/9 6" ² @ 3006**Bart 3007**

TD 3330

Flow 150 Pot.

2 M Gas

Gravity 39.6

COMPLETED

Cowley

KANSAS
 Map No. 2 Sec. 14 Twp. 34 R. 5E


Well No. 1 O. T. Collier

Ben Gralapp et al. Company

COMPLETED Contractor

SE SW

SECTION PLAT

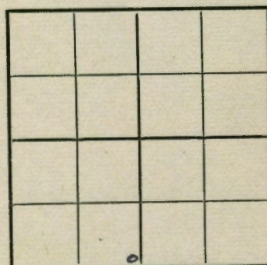

Ft. from N. Line

330 Ft. from S. Line250 Ft. from E. Line

Ft. from W. Line

Miscellaneous

Location _____

Rig up _____

Drilling and Remarks:


RECORD

Cased _____ in., _____ ft.

Sand _____

Gas _____

Oil _____

Total Depth 3920

PRODUCTION

1st 24 hrs. Nat. _____

1st 24 hrs. after shot _____

Gas _____ Cu. Ft.

Dry Hole _____

Abandoned _____

Date

FEB 9 1944 19

S. J. LEWIS

Scout

Cowley

KANSAS
 Map No. 2 Sec. 14 Twp. 34 R. 5E


Well No. 1 O. T. Collier

Ben Gralapp et al. Comp

FIRST REPORT Contract

SE SW

SECTION PLAT

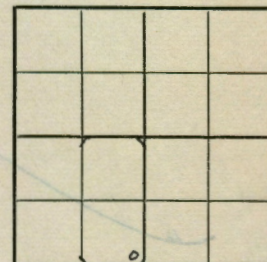

Ft. from N. Line

330 Ft. from S. Line250 Ft. from E. Line

Ft. from W. Line

Miscellaneous

Location _____

Rig up _____

Drilling and Remarks:

Rotary

RECORD

Cased _____ in., _____ ft.

Sand _____

Gas _____

Oil _____

Total Depth _____

PRODUCTION

1st 24 hrs. Nat. _____

1st 24 hrs. after shot _____

Gas _____ Cu. Ft.

Dry Hole _____

Abandoned _____

Date

DEC 2 2 1943 19

S. J. LEWIS

Scout