

Sec. 14 Twp. 34 R. 5EWell No. #5 Rahn Farm _____Gralapp & McNish Company _____

Miscellaneous

_____ Ft. from N. Line

990 Ft. from S. Line

_____ Ft. from E. Line

330 Ft. from W. Line

NW SW SE

1945 **Elev. 1186** REPORT

7/11 Location

7/19 8" @ 97

Drlg. 1155

7/26 Drlg. 2920

8/15 **Bart 3037**

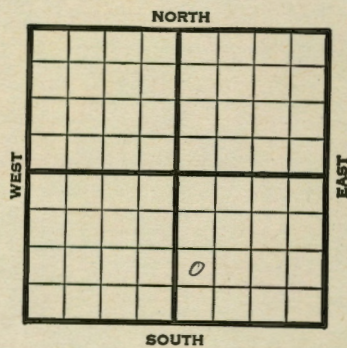
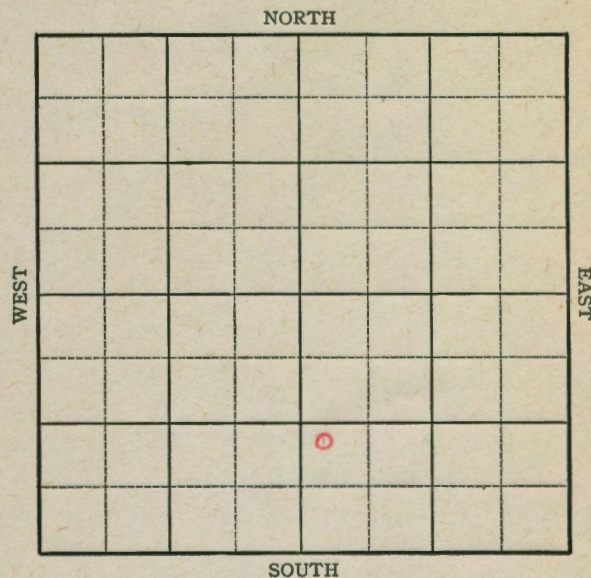
5" @ 3034

20 qts. 3034-3054

TD 3054

Flow 656 Pot.

Grav. 36.0

COMPLETEDSection 14 Township 34 Range 5EWell No. 5 RahnCompany Gralapp & McNish

KANSAS Kansas Pool Name MiscellaneousMap No. 2 Sec. 14 Twp. 34 R. 5EWell No. 5 RahnGralapp and McNish Company

FIRST REPORT

Contractor

NW SW SE

SECTION PLAT

		0	

Ft. from N. Line

990 Ft. from S. Line

Ft. from E. Line

330 Ft. from W. LineCowley CountyLocation X

Rig up

Drilling and Remarks:

RECORD

Cased in, ft.

Sand

Gas

Oil

Total Depth

PRODUCTION

1st 24 hrs. Nat.

1st 24 hrs. after shot

Gas Cu. Ft.

Dry Hole

Abandoned

Date

JUL 11 1945

19

S. J. LEWIS

Scout

KANSAS

Pool Name Miscellaneous

Kansas

Map No. 2 Sec. 14 Twp. 34 R. 5EWell No. 5 RahnGralapp & McNish Company

COMPLETE

Contractor

NW SW SE

SECTION PLAT

		0	

Ft. from N. Line

990 Ft. from S. Line

Ft. from E. Line

330 Ft. from W. LineCowley County

Location

Rig up

Drilling and Remarks:

Bar 730375" @ 3034209 to 3034 - 54Flow 656 bbl96 2/4

RECORD

Cased in, ft.

Sand

Gas

Oil

Total Depth 3054

PRODUCTION

1st 24 hrs. Nat.

1st 24 hrs. after shot

Gas Cu. Ft.

Dry Hole

Abandoned

Date

AUG 15 1945

19

S. J. LEWIS

Scout