


KANSAS

Cowley

Section 14 Township 34 Range 5E
 Well No. 1 Ham-Rahn
 Company McNeish & Gralapp

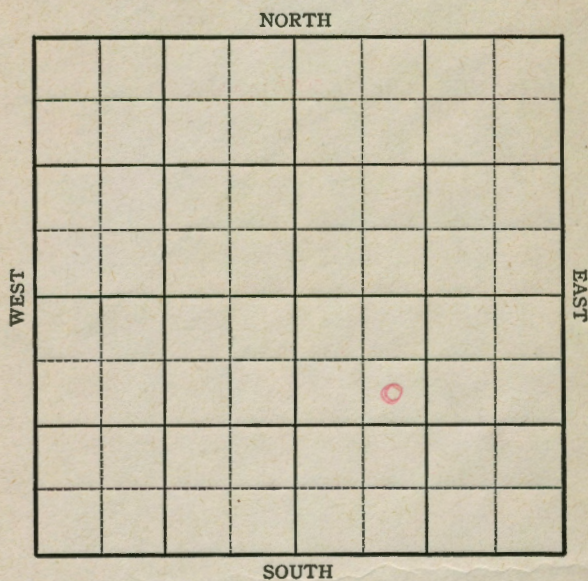


KANSAS

Cowley

Sec. 14 Twp. 34 R. 5-E
 Well No. #1 Ham-Rahn Farm _____
McNeish & Gralapp Company _____

990 Ft. from N. Line
 _____ Ft. from S. Line
 _____ Ft. from E. Line
990 Ft. from W. Line

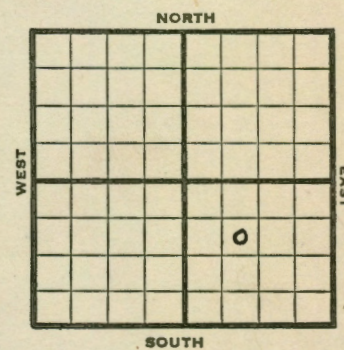

SE NW SE

1945

REPORT

9/19 Drlg. 100'
 9/26 10" @ 102
 Drlg. 1700
 10/3 Bart 2980
 TD 2990'
 Run 5"
 10/10 Bart 2965 corrected
 5" @ 2965
 TD 2980' RUST
 10/17 TD 2990' S.D.
 10/24 TD 3017
 60 qts. CO
 10/31 Bart 2965
 5" @ 2965
 60 qts.
 TD 3017
 Flow 325 Pot.
 Grav. 39.0

COMPLETED

KANSAS Pool Name MiscellaneousMap No. 2 Sec. 14 Twp. 34 R. 5EWell No. 1 Ham-Rahn

McNeish & Gralapp Company

IRST REPORT Contractor


SE NW SE

SECTION PLAT

990 Ft. from N. Line

Ft. from S. Line

Ft. from E. Line

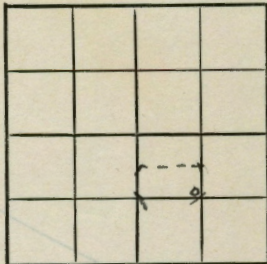990 Ft. from W. Line

Cowley County

Location

RECORD

Cased in, ft.

Sand

Gas

Oil

Total Depth

PRODUCTION

1st 24 hrs. Nat.

1st 24 hrs. after shot

Gas Cu. Ft.

Dry Hole

Abandoned

Date

SEP 19 1945 19

S. J. LEWIS Scout

KANSAS Pool Name MiscellaneousMap No. 2 Sec. 14 Twp. 34 R. 5EWell No. 1 Ham-Rahn

McNeish & Gralapp Company

COMPLETED Contractor


SE NW SE

SECTION PLAT

990 Ft. from N. Line

Ft. from S. Line

Ft. from E. Line

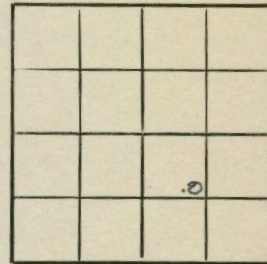990 Ft. from W. Line

Cowley County

Location

RECORD

Cased in, ft.

Sand

Gas

Oil

Total Depth 8017

PRODUCTION

1st 24 hrs. Nat.

1st 24 hrs. after shot

Gas Cu. Ft.

Dry Hole

Abandoned

Date

OCT 31 1945

19

S. J. LEWIS

Scout